


1 LOCATION OF WATER WELL:		Fraction	Section Number	Township Number	Range Number
County:	Stafford	SW 1/4 SW 1/4 NW 1/4	6	T 25 S	R 14W E/W
Distance and direction from nearest town or city street address of well if located within city?					
3 S, 3 3/4 E of Macksville, Kansas					
2 WATER WELL OWNER:		Doyle Wilson	Red Tiger Drilling	Wilson, 2-6	
RR#, St. Address, Box # :	Route 1	1720 Ks. State Bank Bldg.	Board of Agriculture, Division of Water Resources		
City, State, ZIP Code :	Macksville, Ks. 67557	Wichita, Kansas 67202	Application Number: T83-206		

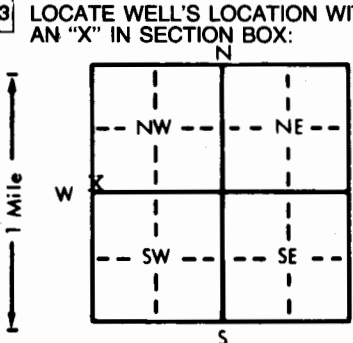

4. DEPTH OF COMPLETED WELL. 80 ft. ELEVATION: . . . Unknown
 Depth(s) Groundwater Encountered 1. . . 20 ft. 2. ft. 3. 6/1/83 ft.
 WELL'S STATIC WATER LEVEL ft. below land surface measured on mo/day/yr
 Pump test data: Well water was ft. after hours pumping gpm
 Est. Yield . . . 60 . . gpm: Well water was ft. after hours pumping gpm
 Bore Hole Diameter in. to 8 ft., and in. to ft.
 WELL WATER TO BE USED AS: 5 Public water supply 8 Air conditioning 11 Injection well
 1 Domestic 3 Feedlot 6 Oil field water supply 9 Dewatering 12 Other (Specify below)
 2 Irrigation 4 Industrial 7 Lawn and garden only 10 Observation well
 Was a chemical/bacteriological sample submitted to Department? Yes.....No.....; If yes, mo/day/yr sample was sub
 mitted Water Well Disinfected? Yes No

5 TYPE OF BLANK CASING USED:		3 Wrought iron		8 Concrete tile		CASING JOINTS: Glued		Clamped	
1 Steel		3 RMP (SR)		6 Asbestos-Cement		9 Other (specify below)		Welded	
2 <u>PVC</u>		4 ABS		7 Fiberglass				Threaded	
Blank casing diameter		5 in. to 60 ft., Dia.		in. to ft., Dia.		in. to		ft.	
Casing height above land surface		12 in., weight		2.8 lbs./ft.		Wall thickness or gauge No.		Shh. 40	
TYPE OF SCREEN OR PERFORATION MATERIAL:				7 PVC		10 Asbestos-cement			
1 Steel		3 Stainless steel		5 Fiberglass		8 <u>RMP (SR)</u>		11 Other (specify)	
2 Brass		4 Galvanized steel		6 Concrete tile		9 ABS		12 None used (open hole)	
SCREEN OR PERFORATION OPENINGS ARE:				5 Gauzed wrapped		8 <u>Saw cut</u>		11 None (open hole)	
1 Continuous slot		3 Mill slot		6 Wire wrapped		9 Drilled holes			
2 Louvered shutter		4 Key punched		7 Torch cut		10 Other (specify)			
SCREEN-PERFORATED INTERVALS:		From		60 ft. to 80 ft.,		From		ft. to ft.	
		From		ft. to ft.,		From		ft. to ft.	
GRAVEL PACK INTERVALS:		From		10 ft. to 80 ft.,		From		ft. to ft.	
		From		ft. to ft.,		From		ft. to ft.	

6 GROUT MATERIAL:		1 Neat cement	2 Cement grout	3 Bentonite	4 Other
Grout Intervals:		From 0 ft. to 10 ft.	From	ft. to	ft.
What is the nearest source of possible contamination:				10 Livestock pens	14 Abandoned water well
1 Septic tank	4 Lateral lines	7 Pit privy	11 Fuel storage	15 Oil well/Gas well	
2 Sewer lines	5 Cess pool	8 Sewage lagoon	12 Fertilizer storage	16 Other (specify below)	
3 Watertight sewer lines	6 Seepage pit	9 Feedyard	13 Insecticide storage		
Direction from well?		South	How many feet?		60

[illegible]

7 CONTRACTOR'S OR LANDOWNER'S CERTIFICATION: This water well was (1) constructed, (2) reconstructed, or (3) plugged under my jurisdiction and was completed on (mo/day/year) 6/1/83 and this record is true to the best of my knowledge and belief. Kansas Water Well Contractor's License No. 186 This Water Well Record was completed on (mo/day/yr) 8/15/83 under the business name of Kellys Water Well Service by (signature) Deon Bond

INSTRUCTIONS: Use typewriter or ball point pen, PLEASE PRESS FIRMLY and PRINT clearly. Please fill in blanks, underline or circle the correct answers. Send top three copies to Kansas Department of Health and Environment, Division of Environment, Environmental Geology Section, Topeka, KS 66620. Send one to WATER WELL OWNER and retain one for your records.