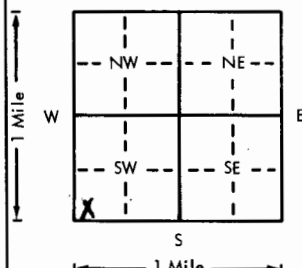


USE TYPEWRITER OR BALL
POINT PEN-PRESS FIRMLY,
PRINT CLEARLY.

WATER WELL RECORD
KSA 82a-1201-1215

Kansas Department of Health and
Environment-Division of Environment
(Water well Contractors)
Topeka, Kansas 66620

1. Location of well:		County Stafford	Fraction SW 1/4 SW 1/4 SW 1/4	Section number 9	Township number T 25 S	Range number R 14 E (W)
2. Distance and direction from nearest town or city: 6 mi South of Dillwin, Ks. East side				3. Owner of well: B & T Drilling R.R. or street: Box 846 City, state, zip code: Independence, Kansas 67301		
4. Locate with "X" in section below:		Sketch map:		6. Bore hole dia. 9 1/8 in. Completion date 7-31-78 Well depth 60 ft.		
				7. ☐ Cable tool ☒ Rotary ☐ Driven ☐ Dug ☐ Hollow rod ☐ Jetted ☐ Bored ☐ Reverse rotary		
5. Type and color of material		From	To	8. Use: ☐ Domestic ☐ Public supply ☐ Industry ☐ Irrigation ☐ Air conditioning ☐ Stock ☐ Lawn ☒ Oil field water ☐ Other		
Top soil		0	2	9. Casing: Material ☐ Height: Above or below Threaded ☐ Welded ☒ Surface 18 in. RMP ☐ PVC ☐ Weight ☐ lbs./ft. Dia. 4 1/2 in. to 100 ft. depth Wall Thickness: inches or Dia. ☐ in. to ☐ ft. depth gage No. 237		
Brown clay		2	15	10. Screen: Manufacturer's name Certaineed Type PVC Dia. ☐ Slot/gauge 1/16 Length 20' Set between 60 ft. and 40 ft. ft. and ☐ ft.		
Sand & Gravel		15	61	Gravel pack? ☒ Size range of material 1/2, 3/4, 4		
Brown clay & white clay		61	68	11. Static water level: ☐ mo./day/yr. 14 1/2 ft. below land surface Date 7-31-78		
				12. Pumping level below land surfaces: ☐ ft. after 1st pumping ☐ g.p.m. ☐ ft. after 1st pumping ☐ g.p.m. Estimated maximum yield ☐ g.p.m.		
				13. Water sample submitted: ☐ mo./day/yr. ☐ Yes ☒ No Date ☐		
				14. Well head completion: ☐ Pitless adapter ☐ Inches above grade		
				15. Well grouted? ☒ With: ☒ Neat cement ☐ Bentonite ☐ Concrete Depth: From 0 ft. to 10 ft.		
				16. Nearest source of possible contamination: oil ft. 75' Direction W Type well Well disinfected upon completion? ☒ Yes ☐ No		
				17. Pump: ☒ Not installed Manufacturer's name ☐ Model number ☐ HP ☐ Volts ☐ Length of drop pipe ☐ ft. capacity ☐ g.p.m. Type: ☐ Submersible ☐ Turbine ☐ Jet ☐ Reciprocating ☐ Centrifugal ☐ Other		
18. Elevation:		19. Remarks:		20. Water well contractor's certification: This well was drilled under my jurisdiction and this report is true to the best of my knowledge and belief. Rosemcrantz - Bemis Business name License No. ☐ Address Great Bend, Ks. 67530 Signed Sandy Kilgus Date 9-7-78 Authorized representative		