USE TYPEWRITER OR BALL POINT PEN-PRESS FIRMLY, PRINT CLEARLY.

WATER WELL RECORD
KSA 82a-1201-1215

Kansas Department of Health and Environment-Division of Environment
(Water well Contractors)
Topeka, Kansas 66620

1. Location of well:	County	Fraction	Section number	Township number	Range number
	STAFFORD	NE 1/4 NE 1/4 NW 1/4	14	T 25 S	R 14 W E/W

2. Distance and direction from nearest town or city: 8S 4½ W
Street address of well location if in city: of ST JOHN Ks

3. Owner of well: IDA MAE TANNER
R.R. or street:
City, state, zip code: ST. JOHN, KANSAS

4. Locate with "X" in section below:

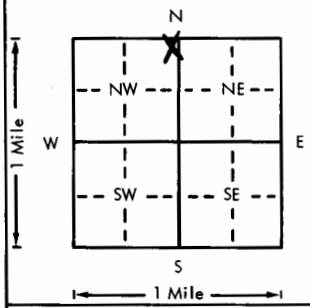

Sketch map:

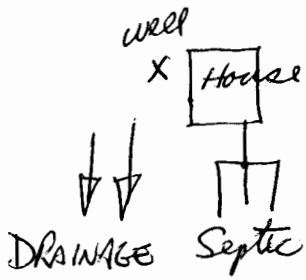

6. Bore hole dia. 10 in. Completion date ____
Well depth 80 ft. 23 Feb 79

7. __ Cable tool X Rotary __ Driven __ Dug
__ Hollow rod __ Jetted __ Bored __ Reverse rotary

8. Use: X Domestic __ Public supply __ Industry
__ Irrigation __ Air conditioning __ Stock
__ Lawn __ Oil field water __ Other

9. Casing: Material ____ Height: Above or below
Threaded ____ Welded ____ Surface 12 in.
RMP ____ PVC X Weight ____ lbs./ft.
Dia. 5 in. to 60 ft. depth Wall Thickness: inches or
Dia. ____ in. to ____ ft. depth gage No. 258

5. Type and color of material	From	To
Soil	0	2
Sand, silty	2	38
Sand, fine to Coarse & Coarse gravel	38	45
Clay, green	45	50
Sand, fine to Coarse & fine gravel	50	60
Sand, fine to Coarse & med Gravel	60	75
Sand, [redacted] Coarse & Coarse gravel	75	90

(Use a second sheet if needed)

10. Screen: Manufacturer's name Peerless
Type Saw Slot Dia. 5"
Slot/gauze 18 Length 20'
Set between 60 ft. and 80 ft.
____ ft. and ____ ft.
Gravel pack? X Size range of material ⅛ X ¼

11. Static water level: mo./day/yr.
37.5 ft. below land surface Date 23 Feb 79

12. Pumping level below land surfaces:
____ ft. after ____ hrs. pumping ____ g.p.m.
____ ft. after ____ hrs. pumping ____ g.p.m.
Estimated maximum yield 60 g.p.m.

13. Water sample submitted: mo./day/yr.
__ Yes X No Date ____

14. Well head completion:
X Pitless adapter 12 Inches above grade

15. Well grouted? X
With: X Neat cement ____ Bentonite ____ Concrete
Depth: From 4 ft. to 14 ft.

16. Nearest source of possible contamination:
ft. 110 Direction SE Type Septic
Well disinfected upon completion? X Yes ____ No

17. Pump: ____ Not installed
Manufacturer's name STA RITE
Model number 20 HP ½ Volts ____
Length of drop pipe 60 ft. capacity 18 g.p.m.
Type:
X Submersible ____ Turbine
____ Jet ____ Reciprocating
____ Centrifugal ____ Other

18. Elevation:

Topography:
____ Hill
____ Slope
X Upland
____ Valley

19. Remarks:
4'X4'X4" Slab Poured below Pitless Adapter

20. Water well contractor's certification:
This well was drilled under my jurisdiction and this report is true to the best of my knowledge and belief.
Central Well & Pump 325
Business name License No.
Address Box 1032 Pratt Ks
Signed [illegible] Date ____
Authorized representative 1 mar 79

25 T 14 R (E) (W) 14 Sec NE NE NW 1/4 1/4 1/4

Forward the white, blue and pink copies to the Department of Health and Environment

Form WWC-5