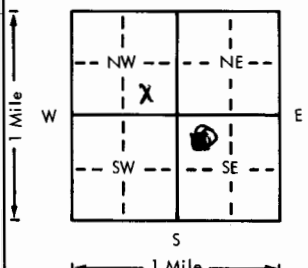


USE TYPEWRITER OR BALL
POINT PEN-PRESS FIRMLY,
PRINT CLEARLY.

WATER WELL RECORD
KSA 82a-1201-1215

Kansas Department of Health and
Environment-Division of Environment
(Water well Contractors)
Topeka, Kansas 66620

1. Location of well: County STAFFORD		Fraction C 1/4 SE 1/4 NW 1/4	Section number 20	Township number T 25 S	Range number R 14 W	E/W
2. Distance and direction from nearest town or city: Radium 24 south 1/2 west			3. Owner of well: Huskey Drilling Co. R.R. or street: City, state, zip code: GT Bend KS			
4. Locate with "X" in section below:		Sketch map:		X Bore hole dia. _____ in. Completion date _____ Well depth 60 ft. 8-10-78		
				7. Cable tool ☒ Rotary _____ Driven _____ Dug _____ Hollow rod _____ Jetted _____ Bored _____ Reverse rotary _____		
5. Type and color of material		From	To	8. Use: _____ Domestic _____ Public supply _____ Industry _____ Irrigation _____ Air conditioning _____ Stock _____ Lawn ☒ Oil field water _____ Other _____		
Clay		0	18	X Casing: Material _____ Height: Above or below Threaded _____ Welded ☒ Surface 12 in. RMP _____ PVC ☒ Weight 278-3 lbs./ft. Dia. 5 in. to 60 ft. depth Wall Thickness: inches or Dia. _____ in. to _____ ft. depth gage No. 200		
Fine Sand		18	40	10. Screen: Manufacturer's name Terrill's shop made Type Saw Dia. 5 Slot/gauze 1/8 Length 20 Set between 60 ft. and 40 ft. _____ ft. and _____ ft. Gravel pack yes Size range of material 1/4-1/8		
Gravel		40	60	11. Static water level: _____ mo./day/yr. 18 ft. below land surface Date 8-10-78		
				12. Pumping level below land surfaces: _____ ft. after _____ hrs. pumping _____ g.p.m. _____ ft. after _____ hrs. pumping _____ g.p.m. Estimated maximum yield _____ g.p.m.		
				13. Water sample submitted: _____ mo./day/yr. Yes ☒ No _____ Date _____		
				14. Well head completion: _____ Pitless adapter 12 inches above grade		
				15. Well grouted? yes With: _____ Neat cement ☒ Bentonite _____ Concrete _____ Depth: From 40 ft. to 0 ft.		
				16. Nearest source of possible contamination: ft. _____ Direction _____ Type _____ Well disinfected upon completion? _____ Yes _____ No		
				17. Pump: _____ Not installed Manufacturer's name _____ Model number _____ HP _____ Volts _____ Length of drop pipe _____ ft. capacity _____ g.p.m. Type: _____ Submersible _____ Turbine _____ Jet _____ Reciprocating _____ Centrifugal _____ Other _____		
18. Elevation:		19. Remarks:		20. Water well contractor's certification: This well was drilled under my jurisdiction and this report is true to the best of my knowledge and belief. Myers WaterWell 143 Business name _____ License No. _____ Address GT Bend KS Signed Hayes Randall Date 8-10-78 Authorized representative		

25-140-20 CSENU
T
R
E
Sec
1/4 1/4 1/4