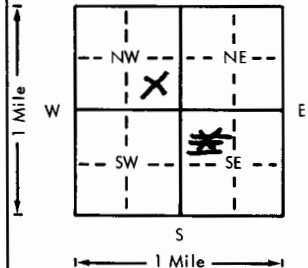


USE TYPEWRITER OR BALL
POINT PEN-PRESS FIRMLY,
PRINT CLEARLY.

WATER WELL RECORD
KSA 82a-1201-1215

Kansas Department of Health and
Environment-Division of Environment
(Water well Contractors)
Topeka, Kansas 66620

1. Location of well:		County STAFFORD	Section C 1/4 SE 1/4 NW 1/4	Section number 20	Township number T 25 S	Range number S R 14 W	E/W
2. Distance and direction from nearest town or city: Dilwyn Rd Hwy 50 South To Emersor Rd 1/2 Street address of well location if in city: WEST				3. Owner of well: Huskey Drlg R.R. or street: City, state, zip code: Shelton Mo			
☒ Locate with "X" in section below:		Sketch map:		6. Bore hole dia. 9 in. Completion date Well depth 26 ft. 8-18-78			
				7. ☒ Cable tool ☒ Rotary ☐ Driven ☐ Dug ☐ Hollow rod ☐ Jetted ☐ Bored ☐ Reverse rotary			
5. Type and color of material				8. Use: ☐ Domestic ☐ Public supply ☐ Industry ☐ Irrigation ☐ Air conditioning ☐ Stock ☐ Lawn ☒ Oil field water ☐ Other			
				9. Casing: Material ☐ Height: Above or below Threaded ☐ Welded ☒ Surface 12 in. RMP ☐ PVC ☒ Weight 298-3 lbs./ft. Dia. 5 in. to 26 ft. depth Wall Thickness: inches or Dia. ☐ in. to ☐ ft. depth Gauge No. 200			
				10. Screen: Manufacturer's name Peerless Mfg Type Saw Dia. 5 Slot/gauze ☐ Length 20 Set between 75 ft. and 55 ft. ☐ ft. and ☐ ft. Gravel pack? yes Size range of material 1/4-1/8			
				11. Static water level: ☐ mo./day/yr. 6 ft. below land surface Date 8-18-78			
				12. Pumping level below land surfaces: ☐ ft. after ☐ hrs. pumping ☐ g.p.m. ☐ ft. after ☐ hrs. pumping ☐ g.p.m. Estimated maximum yield ☐ g.p.m.			
				13. Water sample submitted: ☐ mo./day/yr. ☐ Yes ☒ No Date ☐			
				14. Well head completion: ☐ Pitless adapter 12 Inches above grade			
				15. Well grouted? yes With: ☐ Neat cement ☒ Bentonite ☐ Concrete Depth: From 6 ft. to 12 ft.			
				16. Nearest source of possible contamination: ft. ☐ Direction ☐ Type ☐ Well disinfected upon completion? ☐ Yes ☐ No			
				17. Pump: ☐ Not installed Manufacturer's name ☐ Model number ☐ HP ☐ Volts ☐ Length of drop pipe ☐ ft. capacity ☐ g.p.m. Type: ☐ Submersible ☐ Turbine ☐ Jet ☐ Reciprocating ☐ Centrifugal ☐ Other			
				(Use a second sheet if needed)			
18. Elevation:		19. Remarks:		20. Water well contractor's certification: This well was drilled under my jurisdiction and this report is true to the best of my knowledge and belief. Myer Water Well 143 Business name Great Bend KS License No. CS 6114 Address Flayd Raymond Date 8-18-78 Signature Flayd Raymond Authorized representative			