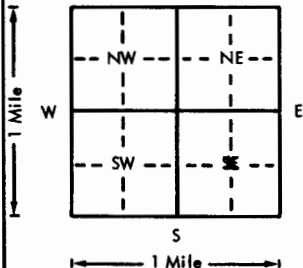


USE TYPEWRITER OR BALL
POINT PEN-PRESS FIRMLY,
PRINT CLEARLY.

WATER WELL RECORD
KSA 82a-1201-1215

Kansas Department of Health and
Environment-Division of Environment
(Water well Contractors)
Topeka, Kansas 66620

1. Location of well:	County Stafford	Fraction 1/4 1/4 CSE 1/4	Section number 24	Township number T 25 S	Range number R 14 E
2. Distance and direction from nearest town or city: 1 1/2 mi. Southwest of St. John, KS Street address of well location if in city:			3. Owner of well: Eldon Bunker R.R. or street: Route 1 City, state, zip code: St. John, KS 67576		
4. Locate with "X" in section below: Sketch map: 			6. Bore hole dia. 24 in. Completion date 5-5-76 Well depth 130 ft.		
5. Type and color of material			7. ☐ Cable tool ☐ Rotary ☐ Driven ☐ Dug ☐ Hollow rod ☐ Jetted ☐ Bored ☒ Reverse rotary		
Sand			8. Use: ☐ Domestic ☐ Public supply ☐ Industry ☒ Irrigation ☐ Air conditioning ☐ Stock ☐ Lawn ☐ Oil field water ☐ Other		
Gray & brown clay			9. Casing: Material Steel Height: Above or below Threaded ☐ Welded ☒ Surface 12 in. RMP ☐ PVC ☐ Weight 30.3 lbs./ft. Dia. 16 in. to 60 ft. depth Wall Thickness: inches or Dia. ☐ in. to ☐ ft. depth gage No. 7 ga.		
Brown & gray clay & sand streaks			10. Screen: Manufacturer's name W. A. Brown Type Double-slot Dia. 16" ☒ Slot gauze 1/8 Length 70' Set between 60 ft. and 130 ft. ft. and ☐ ft.		
Sand & gravel			Gravel pack? Yes Size range of material 3/8-200		
Brown & white clay & limestone			11. Static water level: ☐ mo./day/yr. 23 ft. below land surface Date 4-19-76		
Sand & gravel			12. Pumping level below land surfaces: N/C ft. after ☐ hrs. pumping ☐ g.p.m. ft. after ☐ hrs. pumping ☐ g.p.m. Estimated maximum yield ☐ g.p.m.		
Brown & white clay & limestone			13. Water sample submitted: ☐ mo./day/yr. Yes ☒ No Date ☐		
Sand, gravel & clay streaks at 87'			14. Well head completion: ☐ Pitless adapter 12 inches above grade		
Yellow clay			15. Well grouted? Yes With: ☒ Neat cement ☐ Bentonite ☐ Concrete Depth: From 0 ft. to 10 ft.		
Sand & gravel			16. Nearest source of possible contamination: ft. ☐ Direction ☐ Type ☐ Well disinfected upon completion? ☐ Yes ☒ No		
(Use a second sheet if needed)			17. Pump: ☐ Not installed Manufacturer's name FMC Corp./Peerless Model number 12LB-3 HP 80 Volts ☐ Length of drop pipe 70 ft. capacity 900 g.p.m. Type: ☐ Submersible ☒ Turbine ☐ Jet ☐ Reciprocating ☐ Centrifugal ☐ Other		
18. Elevation:	19. Remarks:		20. Water well contractor's certification: This well was drilled under my jurisdiction and this report is true to the best of my knowledge and belief. Clarke Well & Eq., Inc. 185 Business name Great Bend, KS License No. Address Great Bend, KS Signed [Signature] Date 5-19-76 Authorized representative		