


USE TYPEWRITER OR BALL
POINT PEN-PRESS FIRMLY,
PRINT CLEARLY.

WATER WELL RECORD
KSA 82a-1201-1215

Kansas State Dept. Of Health
(Water Well Contractors)
Forbes-Bldg. 740
Topeka, Kansas 66620

1 Location of well:	County Stafford	Township name	Fraction C N 1/2 SW	Section number 27	Town number 25	Range number 14 W
---------------------	---------------------------	---------------	-------------------------------	-----------------------------	--------------------------	-----------------------------

Distance and direction from nearest town or city: 9 South 6 West	3 Owner of well: Search Drilling Co
Street address of well location if in city: 1/2 south of St John	
Address: wiles unit #1 250. No Rock Rd.	

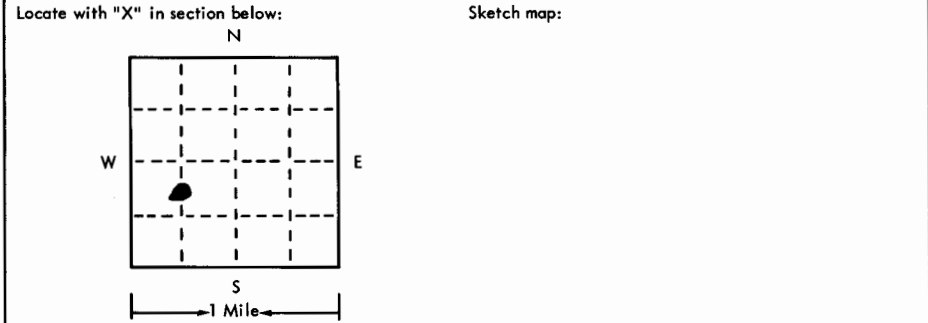

4 Well depth: **90** ft. Date of completion **2-26-75**
Well diameter **1 1/2** in.

5 Cable tool Rotary Driven Dug
 Hollow rod Jetted Bored Reverse rotary

6 Use: Domestic Public supply Industry
 Irrigation Air conditioning Commercial
 Test well

7 Casing Material **PVC Plastic** Height: above/below
Threaded Welded Surface in.
Diam. **4** in. to **90** ft. depth Weight lbs./ft. No
Drive shoe? Yes No

2	Type and color of material	From	To
	Clay	0	20
	Sand	20	25
	Clay	25	60
	Sand	60	70
	Gravel	70	90
Plugged by Theodore Heiter			
RR1			
Pratt, KS 67124			
conversation with search DR26			
on 3/27/75 DWB			
(use a second sheet if needed)			

8 Screen:
Manufacturer **Jess & Lowell**
Type **slotted** Dia. _____
Slot/gauze **5** Length **20**
Set between **90** ft. and **96** ft. _____
Fittings:
Gravel pack Yes No Size range of material **5-1/4**

9 Static water level:
16 ft. below land surface Date **2-26-75**

10 Pumping level below land surfaces:
_____ ft. after _____ hrs. pumping _____ g.p.m.
_____ ft. after _____ hrs. pumping _____ g.p.m.
Estimated maximum yield **125** g.p.m.

11 Water sample submitted:
 Yes No Date _____

12 Well head completion:
 Pitless adapter **12** inches above grade

13 Well grouted? Yes No
 Neat cement Bentonite _____
Depth: From **0** ft. to **12** ft.

14 Nearest source of possible contamination:
ft. **100** Direction **east** Type **drift water**
Well disinfected upon completion? Yes No

15 Pump: Not installed
Manufacturer's name _____
Model number _____ HP _____ Volts _____
Length of drop pipe _____ ft. capacity _____ g.m.p.
Type:
 Submersible Turbine
 Jet Reciprocating
 Centrifugal Other

16 Remarks: elevation

Topography:
 Hill
 Slope
 Upland
 Valley

17 Water well contractor's certification:
This well was drilled under my jurisdiction and this report is true to the best of my knowledge and belief.

Myers Water Well 143
Business name License No. _____
Address **Beat Bend KS**
Signed **Arford Myers** Date **2-26-75**
Authorized representative