USE TYPEWRITER OR BALL POINT PEN-PRESS FIRMLY, PRINT CLEARLY.

T	R	EW	sec	1/4	1/4	1/4	No.

WATER WELL RECORD
KSA 82a-1201-1215

Kansas State Dept. Of Health
(Water Well Contractors)
Forbes-Bldg. 740
Topeka, Kansas 66620

1 Location of well: County	Township name	Fraction	Section number	Town number	Range number
Stafford	Albana	CSW¼	28	T25S	R14W

Distance and direction from nearest town or city:
12½ mi. Southeast of Macksville, Kansas
Street address of well location if in city:

3 Owner of well: Richard Waters
Address: St. John, KS

Locate with "X" in section below:

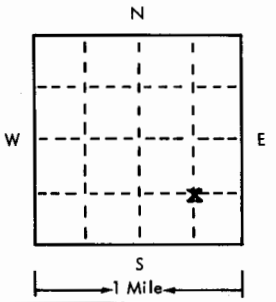

Sketch map:

4 Well depth: 113 ft. Date of completion 8-8-75
Well diameter 24 in.

5 ☐ Cable tool ☐ Rotary ☐ Driven ☐ Dug
☐ Hollow rod ☐ Jetted ☐ Bored ☒ Reverse rotary

6 Use: ☐ Domestic ☐ Public supply ☐ Industry
☒ Irrigation ☐ Air conditioning ☐ Commercial
☐ Test well ☐

7 Casing: Material Steel Height: above/below
Threaded ☐ Welded ☒ Surface 12 in.
Diam. Weight 30.3 lbs./ft.
16 in. to 73 ft. depth Drive shoe? ☐ Yes ☒ No
___ in. to ___ ft. depth

8 Screen:
Manufacturer Doerr
Type Double-slot Dia. 16"
Slot/gauze 1/8 Length 40'
Set between 73 ft. and 113 ft.
Fittings:
Gravel pack ☒ Yes ☐ No Size range of material 3/8—200

9 Static water level:
19½ ft. below land surface Date 8-8-75

10 Pumping level below land surfaces: N/C
___ ft. after ___ hrs. pumping ___ g.p.m.
___ ft. after ___ hrs. pumping ___ g.p.m.
Estimated maximum yield ___ g.p.m.

11 Water sample submitted:
☐ Yes ☒ No Date ___

12 Well head completion:
☐ Pitless adapter 12 ☐ Inches above grade

13 Well grouted? ☒ Yes ☐ No
☒ Neat cement ☐ Bentonite ☐
Depth: From 0 ft. to 10 ft.

14 Nearest source of possible contamination: NONE KNOWN
ft. ___ Direction ___ Type ___
Well disinfected upon completion? ☐ Yes ☒ No

15 Pump: ☒ Not installed
Manufacturer's name ___
Model number ___ HP ___ Volts ___
Length of drop pipe ___ ft. capacity ___ g.m.p.
Type:
☐ Submersible ☐ Turbine
☐ Jet ☐ Reciprocating
☐ Certrifugal ☐ Other

2 Type and color of material	From	To
Top soil & sand	0	8
Brown & gray clay & limestone	8	44
Gravel	44	47
Gray clay	47	54
Sand & gravel	54	62
Brown & gray clay	62	73
Sand, gravel & clay streak at 89'	73	113
(use a second sheet if needed)		

16 Remarks: elevation

Topography:
☐ Hill
☐ Slope
☐ Upland
☐ Valley

17 Water well contractor's certification:
This well was drilled under my jurisdiction and this report is true to the best of my knowledge and belief.
CLARKE WELL & EQ., INC. 185
Business name License No.
Address Great Bend, KS
Signed [signature] Date 8-8-75
Authorized representative

Forward the white, blue and pink copies to the Kansas State Dept. Of Health.

Form WWC-5