


1 LOCATION OF WATER WELL:		Fraction	Section Number	Township Number	Range Number
County:	Stafford	SE ¼ SE ¼ SE ¼	29	T 25 S	R 14 W E/W

Distance and direction from nearest town or city street address of well if located within city?
5E 8S of Macksville, Kansas

2	WATER WELL OWNER: Stanley McAhren	
	RR#, St. Address, Box # : RR	Board of Agriculture, Division of Water Resources
	City, State, ZIP Code : Byers, Kansas 67021	Application Number:

3 LOCATE WELL'S LOCATION WITH AN "X" IN SECTION BOX: 4 DEPTH OF COMPLETED WELL: 90 ft. ELEVATION:
 Depth(s) Groundwater Encountered 1. 31 ft. 2. ft. 3. ft.

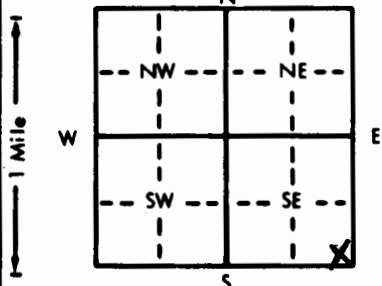

4 DEPTH OF COMPLETED WELL... 90... ft. ELEVATION:
 Depth(s) Groundwater Encountered 1. 31... ft. 2. ft. 3. ft.
 WELL'S STATIC WATER LEVEL... 31... ft. below land surface measured on mo/day/yr... 19 May 86
 Pump test data: Well water was ft. after hours pumping gpm
 Est. Yield... 80... gpm: Well water was ft. after hours pumping gpm
 Bore Hole Diameter... 10... in. to... 90... ft., and... in. to... ft.
 WELL WATER TO BE USED AS: 5 Public water supply 8 Air conditioning 11 Injection well
~~301~~ Domestic 3 Feedlot 6 Oil field water supply 9 Dewatering 12 Other (Specify below)
 2 Irrigation 4 Industrial 7 Lawn and garden only 10 Observation well stock
 Was a chemical/bacteriological sample submitted to Department? Yes..... No..... X.....; If yes, mo/day/yr sample was sub
 mitted Water Well Disinfected? Yes X No

5	TYPE OF BLANK CASING USED:	5 Wrought iron	8 Concrete tile	CASING JOINTS: Glued ☒ Clamped ☐
	1 Steel	3 RMP (SR)	6 Asbestos-Cement	9 Other (specify below)
	2 PVC	4 ABS	7 Fiberglass	Welded ☐
				Threaded ☐

Blank casing diameter . . . 4 . . . in. to . . . 70 . . . ft., Dia . . . in. to . . . ft., Dia . . . in. to . . . ft.
Casing height above land surface . . . 12 . . . in., weight . . . 1.531 . . . lbs./ft. Wall thickness or gauge No. . . 173

TYPE OF SCREEN OR PERFORATION MATERIAL:			<u>xx 7 PVC</u>	10 Asbestos-cement
1 Steel	3 Stainless steel	5 Fiberglass	8 RMP (SR)	11 Other (specify)
2 Brass	4 Galvanized steel	6 Concrete tile	9 ABS	12 None used (open hole)

SCREEN OR PERFORATION OPENINGS ARE:		5 Gauzed wrapped	xxx 8 Saw cut	11 None (open hole)
1 Continuous slot	3 Mill slot	6 Wire wrapped	9 Drilled holes	
2 Louvered shutter	4 Key punched	7 Torch cut	10 Other (specify)	

SCREEN-PERFORATED INTERVALS:	From	70	ft. to	90	ft., From	ft. to	ft.
	From		ft. to		ft., From	ft. to	ft.
GRAVEL PACK INTERVALS:	From	10	ft. to	90	ft., From	ft. to	ft.
	From		ft. to		ft., From	ft. to	ft.

6 GROUT MATERIAL: 1 Neat cement XXX 2 Cement grout 3 Bentonite 4 Other

Grout Intervals: From 0 ft. to 10 ft., From ft. to ft., From ft. to ft.

What is the nearest source of possible contamination:			10 Livestock pens	14 Abandoned water well
1 Septic tank	4 Lateral lines	7 Pit privy	11 Fuel storage	15 Oil well/Gas well
2 Sewer lines	5 Cess pool	8 Sewage lagoon	12 Fertilizer storage	16 Other (specify below)
3 Watertight sewer lines	6 Seepage pit	9 Feedyard	13 Insecticide storage	 none
Direction from well?			How many feet?	

[illegible]

7 CONTRACTOR'S OR LANDOWNER'S CERTIFICATION: This water well was (1) constructed, (2) reconstructed, or (3) plugged under my jurisdiction and was completed on (mo/day/year) 19. May. 86 and this record is true to the best of my knowledge and belief. Kansas Water Well Contractor's License No. 325 This Water Well Record was completed on (mo/day/yr) 20. June. 86 under the business name of Central Well and Pump by (signature) [Signature]

INSTRUCTIONS: Use typewriter or ball point pen. **PLEASE PRESS FIRMLY** and **PRINT** clearly. Please fill in blanks, underline or circle the correct answers. Send top three copies to Kansas Department of Health and Environment, Office of Oil Field and Environmental Geology, Regulation and Permitting Section, Topeka, Kansas 66620-7500, Telephone: 913-862-9360. Send one to **WATER WELL OWNER** and retain one for your records.