USE TYPEWRITER OR BALL POINT PEN-PRESS FIRMLY, PRINT CLEARLY.

WATER WELL RECORD
KSA 82a-1201-1215

Kansas Department of Health and Environment-Division of Environment
(Water well Contractors)
Topeka, Kansas 66620

1. Location of well:	County	Fraction	Section number	Township number	Range number
	Stafford	1/4 1/4 CNW 1/4	30	T 25 S	R 14 E (W)

2. Distance and direction from nearest town or city:
9½ mi. Southeast of Macksville, KS.
Street address of well location if in city:

3. Owner of well: Gerald Goodman
R.R. or street: Route 2
City, state, zip code: St. John, KS 67576

4. Locate with "X" in section below: Sketch map:

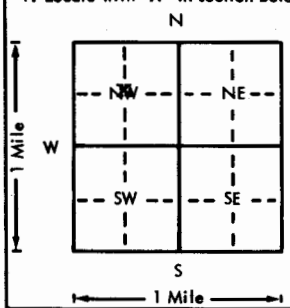

6. Bore hole dia. 24 in. Completion date 4-19-76
Well depth 100 ft.

7. __ Cable tool __ Rotary __ Driven __ Dug
__ Hollow rod __ Jetted __ Bored X Reverse rotary

8. Use: __ Domestic __ Public supply __ Industry
X Irrigation __ Air conditioning __ Stock
__ Lawn __ Oil field water __ Other

9. Casing: Material Steel Height (Above) or below
Threaded __ Welded X Surface 12 in.
RMP __ PVC __ Weight 30.3 lbs./ft.
Dia. 16 in. to 60 ft. depth Wall Thickness: inches or
Dia. __ in. to __ ft. depth gage No. 7 ga.

5. Type and color of material	From	To
Top soil & brown clay	0-	8
Gravel	8	15
Brown clay	15	27
Sand & gravel	27	48
Yellow clay & limestone	48	52
Sand & gravel	52	100
(Use a second sheet if needed)		

10. Screen: Manufacturer's name W. A. Brown
Type Double-slot Dia. 16"
Slot gauze 1/8 Length 40'
Set between 60 ft. and 100 ft.
ft. and ft.
Gravel pack? X Size range of material 3/8-200

11. Static water level: mo./day/yr.
5 ft. below land surface Date 4-16-76

12. Pumping level below land surfaces: N/C
ft. after hrs. pumping g.p.m.
ft. after hrs. pumping g.p.m.
Estimated maximum yield g.p.m.

13. Water sample submitted: mo./day/yr.
__ Yes X No Date

14. Well head completion:
__ Pitless adapter 12 Inches above grade

15. Well grouted? Yes
With: X Neat cement __ Bentonite __ Concrete
Depth: From 0 ft. to 10 ft.

16. Nearest source of possible contamination:
NONE KNOWN
ft. Direction Type
Well disinfected upon completion? __ Yes X No

17. Pump: __ Not installed
Manufacturer's name FMC Corp./Peerless
Model number 12LB-3 HP 80 Volts
Length of drop pipe 60 ft. capacity 900 g.p.m.
Type:
__ Submersible X Turbine
__ Jet __ Reciprocating
__ Centrifugal __ Other

18. Elevation:

Topography:
__ Hill
__ Slope
__ Upland
__ Valley

19. Remarks:

20. Water well contractor's certification:
This well was drilled under my jurisdiction and this report is true to the best of my knowledge and belief.
Clarke Well & Eq. Inc. 185
Business name License No.
Address Great Bend, KS 67530
Signed Authorized representative Date 4-22-76

T 25 R 14 E (W) Sec 30 1/4 1/4 CNW 1/4

Forward the white, blue and pink copies to the Department of Health and Environment

Form WWC-5