


USE TYPEWRITER OR BALL POINT PEN-PRESS FIRMLY, PRINT CLEARLY.

WATER WELL RECORD
KSA 82a-1201-1215

Kansas Department of Health and Environment-Division of Environment
(Water well Contractors)
Topeka, Kansas 66620

1. Location of well: County Stafford Fraction 1/4 1/4 CNE 1/4 Section number 31 Township number T 25 S R 14 Range number E W

2. Distance and direction from nearest town or city: 1 1/2 mi. Southeast of Macksville, KS
Street address of well location if in city:
3. Owner of well: Ray Childs
R.R. or street: Route 2
City, state, zip code: Pratt, KS 67124

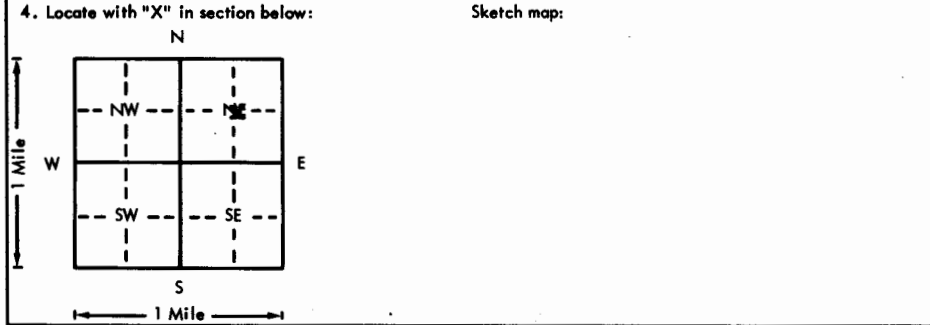

6. Bore hole dia. 24 in. Completion date 9-23-75
Well depth 118 ft.

7. Cable tool Rotary Driven Dug
 Hollow rod Jetted Bored Reverse rotary

8. Use: Domestic Public supply Industry
 Irrigation Air conditioning Stock
 Lawn Oil field water Other

9. Casing: Material Steel Height Above or below
Threaded Welded Surface 12 in.
RMP PVC Weight 30.3 lbs./ft.
Dia. 16 in. to 58 ft. depth Wall Thickness: inches or
Dia. in. to ft. depth gage No.

5. Type and color of material	From	To
Top soil	0	3
Brown & white clay & limestone	3	37
Sand & gravel	37	44
Brown clay	44	50
Sand & gravel	50	72
Brown clay	72	74
Sand & gravel	74	89
Limestone	89	91
Sand & gravel	91	99
Brown clay & limestone	99	106
Sand & gravel	106	118
(Use a second sheet if needed)		

10. Screen: Manufacturer's name W. A. Brown

Type Double-slot Dia. 16"
Slot gauge 1/8 Length 60'
Set between 58 ft. and 118 ft.
 ft. and ft.
Gravel pack? Yes Size range of material 3/8-200

11. Static water level: 13 ft. below land surface Date 9-23-75
mo./day/yr.

12. Pumping level below land surfaces: N/C
 ft. after hrs. pumping g.p.m.
 ft. after hrs. pumping g.p.m.
Estimated maximum yield g.p.m.

13. Water sample submitted: mo./day/yr.
Yes No Date

14. Well head completion:
 Pitless adapter 12 inches above grade

15. Well grouted? Yes
With: Neat cement Bentonite Concrete
Depth: From 0 ft. to 10 ft.

16. Nearest source of possible contamination: NONE KNOWN
ft. Direction Type
Well disinfected upon completion? Yes No

17. Pump: Not installed
Manufacturer's name
Model number HP Volts
Length of drop pipe ft. capacity g.p.m.
Type:
 Submersible Turbine
 Jet Reciprocating
 Centrifugal Other

18. Elevation:

Topography:
 Hill
 Slope
 Upland
 Valley

19. Remarks:

20. Water well contractor's certification:
This well was drilled under my jurisdiction and this report is true to the best of my knowledge and belief.
SW Clarke Well & Eq., Inc. 185
Business name License No.
Address Great Bend, KS
Signed [Signature] Date 9-23-75
Authorized representative