

USE TYPEWRITER OR BALL POINT PEN-PRESS FIRMLY, PRINT CLEARLY.


WATER WELL RECORD
KSA 82a-1201-1215

Kansas Department of Health and Environment-Division of Environment
(Water well Contractors)
Topeka, Kansas 66620

Beck "A"

1. Location of well: County Stafford Fraction S N 1/4 SE 1/4 SW 1/4 Section number 31 Township number T 25 S Range number R 14 W E/W

2. Distance and direction from nearest town or city: 2 north 1 1/2 west Byers
Street address of well location if in city: _____
3. Owner of well: X Ploy Drilling Co
R.R. or street: Michita Kansas
City, state, zip: _____

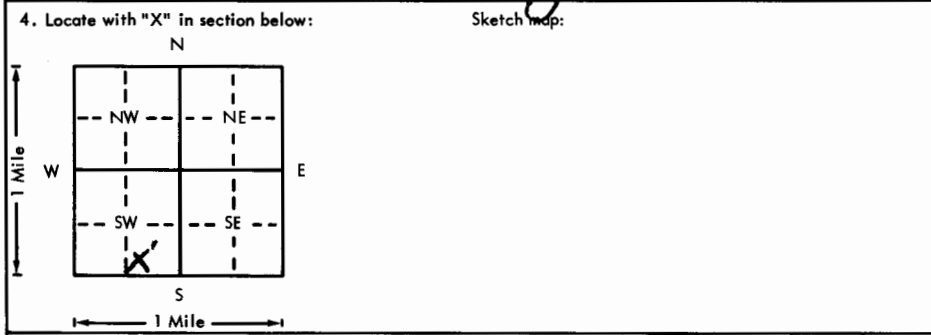

6. Bore hole 8 in. Completion date 12-13-76
Well depth 90 ft.
7. Cable tool Rotary Driven Dug
 Hollow rod Jetted Bored Reverse rotary
8. Use: Domestic Public supply Industry
 Irrigation Air conditioning Stock
 Lawn Oil field water Other
9. Casing: Material Plastic Height: above or below
Threaded Welded Surface 12 in.
RMP PVC Weight 287.3 lbs./ft.
Dia. 5 in. to 90 ft. depth Wall Thickness: inches or
Dia. in. to ft. depth gage No. 200

5. Type and color of material

	From	To
<u>Clay</u>	<u>0</u>	<u>10</u>
<u>Sandy Clay</u>	<u>10</u>	<u>30</u>
<u>Sand</u>	<u>30</u>	<u>70</u>
<u>channel</u>	<u>70</u>	<u>90</u>

10. Screen Manufacturer's name self made
Type 10vc Dia. 5
Slot gauge 3/8 Length 38
Set between 70 ft. and 38 ft.
Gravel pack? yes Size range of material 5-1/4
11. Static water level: 23 ft. below land surface Date 12-13-76
12. Pumping level below land surfaces:
____ ft. after ____ hrs. pumping ____ g.p.m.
____ ft. after ____ hrs. pumping ____ g.p.m.
Estimated maximum yield ____ g.p.m.
13. Water sample submitted: ____ mo./day/yr.
Yes No Date _____
14. Well head completion:
____ Pitless adapter ____ Inches above grade
15. Well grouted? yes
With: ____ Neat cement Bentonite ____ Concrete
Depth: From 0 ft. to 10 ft.
16. Nearest source of possible contamination: None
ft. ____ Direction ____ Type ____
Well disinfected upon completion? ____ Yes ____ No
17. Pump: Not installed
Manufacturer's name ____
Model number ____ HP ____ Volts ____
Length of drop pipe ____ ft. capacity ____ g.p.m.
Type:
____ Submersible ____ Turbine
____ Jet ____ Reciprocating
____ Centrifugal ____ Other

18. Elevation: _____
19. Remarks: _____
20. Water well contractor's certification:
This well was drilled under my jurisdiction and this report is true to the best of my knowledge and belief.
Myers Water Well 143
Business name Great Bend Ks License No. _____
Address _____
Signed R Myers Date 12-1
Authorized representative

T 25 S
 R 14 W
 Sec 31
 SW 1/4 SE 1/4