

1 LOCATION OF WATER WELL:

County: Stafford Fraction: SE 1/4 SE 1/4 S 1/4 Section Number: 28 Township Number: T 25 S Range Number: R 15 E

Distance and direction from nearest town or city street address of well if located within city?

From Marksville / Hwy 50 & Blackhawk Rd / south 8 1/2 West approximately

2 WATER WELL OWNER:

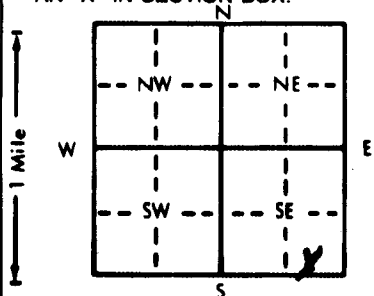
RR#1, St. Address, Box #: RR1 Marksville, KS 67557

Board of Agriculture, Division of Water Resources

City, State, ZIP Code

Application Number:

3 LOCATE WELL'S LOCATION WITH AN "X" IN SECTION BOX:

4 DEPTH OF COMPLETED WELL: 64 ft. ELEVATION:Depth(s) Groundwater Encountered 1. 64 ft. 2. NA ft. 3. NA ft.WELL'S STATIC WATER LEVEL 8-2-02 ft. below land surface measured on mo/day/yrPump test data: Well water was NA ft. after NA hours pumping NA gpmEst. Yield NA gpm Well water was NA ft. after NA hours pumping NA gpmBore Hole Diameter 10 in. to 64 ft. and NA in. to NA ft.

WELL WATER TO BE USED AS: 5 Public water supply 8 Air conditioning 11 Injection well

☒ Domestic 3 Feedlot 6 Oil field water supply 9 Dewatering 12 Other (Specify below)

2 Irrigation 4 Industrial 7 Lawn and garden only 10 Monitoring well

Was a chemical/bacteriological sample submitted to Department? Yes NA No NA; If yes, mo/day/yr sample was submittedWater Well Disinfected? Yes NA No NA

5 TYPE OF BLANK CASING USED:

1 Steel 3 RMP (SR) 5 Wrought iron 8 Concrete tile CASING JOINTS: Glued NA Clamped NA☒ 2 PVC 4 ABS 7 NA 9 Other (specify below) Welded NA Threaded NABlank casing diameter 5 in. to NA ft. Dia. NA in. to NA ft. Dia. NA in. to NA ft.Casing height above land surface 24 in. weight 160 lbs./ft. Wall thickness or gauge No. NA

TYPE OF SCREEN OR PERFORATION MATERIAL:

1 Steel 3 Stainless steel 5 Fiberglass ☒ 7 PVC 10 Asbestos-cement

2 Brass 4 Galvanized steel 6 Concrete tile 8 RMP (SR) 11 Other (specify)

SCREEN OR PERFORATION OPENINGS ARE: 5 Gauzed wrapped 8 Saw cut 11 None (open hole)

☒ 1 Continuous slot 3 Mill slot 6 Wire wrapped 9 Drilled holes

2 Louvered shutter 4 Key punched 7 Torch cut 10 Other (specify)

SCREEN-PERFORATED INTERVALS: From 64 ft. to 44 ft. From NA ft. to NA ft.From NA ft. to NA ft. From NA ft. to NA ft.GRAVEL PACK INTERVALS: From 64 ft. to 20 ft. From NA ft. to NA ft.From NA ft. to NA ft. From NA ft. to NA ft.From NA ft. to NA ft. From NA ft. to NA ft.6 GROUT MATERIAL: 1 Neat cement 2 Cement grout ☒ 3 Bentonite 4 OtherGrout intervals: From 20 ft. to 0 ft. From NA ft. to NA ft. From NA ft. to NA ft.

What is the nearest source of possible contamination:

1 Septic tank 4 Lateral lines 7 Pit privy ☒ 10 Livestock pens 14 Abandoned water well

2 Sewer lines 5 Cess pool 8 Sewage lagoon 11 Fuel storage 15 Oil well/Gas well

3 Watertight sewer lines 6 Seepage pit 9 Feedyard 12 Fertilizer storage 16 Other (specify below)

13 Insecticide storage

Direction from well? West How many feet? 300 ft

FROM TO LITHOLOGIC LOG FROM TO PLUGGING INTERVALS

0 5 Sandy Topsoil

5 20 Tan Clay

20 25 Tan Sand

25 38 Tan Clay

38 64 Coarse Sand

7 CONTRACTOR'S OR LANDOWNER'S CERTIFICATION: This water well was (1) constructed, (2) reconstructed, or (3) plugged under my jurisdiction and was

completed on (mo/day/year) 8-2-02 and this record is true to the best of my knowledge and belief. KansasWater Well Contractor's License No. 673 This Water Well Record was completed on (mo/day/yr) 8-30-02under the business name of Crow's Water Well by (signature) John Crow's