

1 LOCATION OF WATER WELL: County: <u>Stafford</u>	Fraction: <u>SE 1/4 SW 1/4 SW 1/4</u>	Section Number: <u>39</u>	Township Number: <u>T 25 S</u>	Range Number: <u>R 15 E 0</u>
--	---------------------------------------	---------------------------	--------------------------------	-------------------------------


Distance and direction from nearest town or city street address of well if located within city?
8 miles South of Macksville / East Side Rd

2 WATER WELL OWNER: Jason & Kathy Michael
 RR#, St. Address, Box #: Macksville, KS 67557
 City, State, ZIP Code

Board of Agriculture, Division of Water Resources

Application Number:

3 LOCATE WELL'S LOCATION WITH AN "X" IN SECTION BOX:

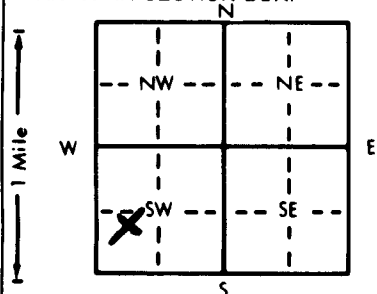

4 DEPTH OF COMPLETED WELL: 65 ft. ELEVATION:


WELL'S STATIC WATER LEVEL 18 ft. below land surface measured on mo/day/yr 12-7-02




WELL WATER TO BE USED AS: 5 Public water supply 8 Air conditioning 11 Injection well

1 Domestic 3 Feedlot 6 Oil field water supply 9 Dewatering 12 Other (Specify below) Stock well

2 Irrigation 4 Industrial 7 Lawn and garden only 10 Monitoring well

Was a chemical/bacteriological sample submitted to Department? Yes X No X; If yes, mo/day/yr sample was submitted

Water Well Disinfected? Yes X No X

5 TYPE OF BLANK CASING USED:

1 Steel 3 RMP (SR) 5 Wrought iron 8 Concrete tile CASING JOINTS: Glued X Clamped X

X 2 PVC 4 ABS 6 Asbestos-Cement 9 Other (specify below) Welded X

Blank casing diameter 5 in. to 45 ft. Dia 12 in. to 160 lbs./ft. Wall thickness or gauge No. 160

Casing height above land surface 12 in., weight 160 lbs./ft.

TYPE OF SCREEN OR PERFORATION MATERIAL:

1 Steel 3 Stainless steel 5 Fiberglass X 7 PVC 10 Asbestos-cement

2 Brass 4 Galvanized steel 6 Concrete tile 9 ABS 11 Other (specify) Stock well

SCREEN OR PERFORATION OPENINGS ARE:

X Continuous slot 3 Mill slot 5 Gauzed wrapped 8 Saw cut 11 None (open hole)

2 Louvered shutter 4 Key punched 6 Wire wrapped 9 Drilled holes

SCREEN-PERFORATED INTERVALS: From 65 ft. to 45 ft. From 65 ft. to 45 ft.

GRAVEL PACK INTERVALS: From 65 ft. to 21 ft. From 65 ft. to 21 ft.



7 CONTRACTOR'S OR LANDOWNER'S CERTIFICATION: This water well was X constructed, (2) reconstructed, or (3) plugged under my jurisdiction and was completed on (mo/day/year) 12-2-02 and this record is true to the best of my knowledge and belief. Kansas

Water Well Contractor's License No. 672 This Water Well Record was completed on (mo/day/yr) 12-10-02

under the business name of Crowd's by (signature) Tom Crowd's