


1	LOCATION OF WATER WELL:	Fraction	Section	Township Number	Range Number
County:	Stafford	NW 1/4 SW 1/4 SW 1/4	4	T 25 S	R 15w E/W

Distance and direction from nearest town or city street address of well if located within city?

3S of Macksville, Ks.

2 WATER WELL OWNER: Myron G. Hamm		Mallard J. V., Inc	
RR#, St. Address, Box # : 7703 Rosewood Drive		P. O. Box 1009	Board of Agriculture, Division of Water Resources
City, State, ZIP Code : Prairie Village, Ks 66208		McPherson, Ks. 67460	Application Number: 980058

3	LOCATE WELL'S LOCATION WITH AN "X" IN SECTION BOX:	4	DEPTH OF COMPLETED WELL..... 93	ft. ELEVATION: unknown
---	--	---	---------------------------------	------------------------

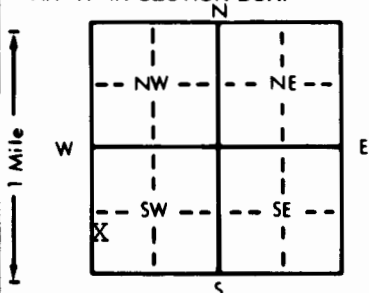

4 DEPTH OF COMPLETED WELL. 93 ft. ELEVATION: unknown

Depth(s) Groundwater Encountered 1. 17 ft. 2. ft. 3. ft.

WELL'S STATIC WATER LEVEL 17 ft. below land surface measured on mo/day/yr 3-24-98

Pump test data: Well water was ft. after hours pumping gpm

Est. Yield 50 gpm: Well water was ft. after hours pumping gpm

Bore Hole Diameter 8 in. to 93 ft., and in. to ft.

WELL WATER TO BE USED AS:

5 Public water supply	8 Air conditioning	11 Injection well		
1 Domestic	3 Feedlot	6 Oil field water supply	9 Dewatering	12 Other (Specify below)
2 Irrigation	4 Industrial	7 Lawn and garden only	10 Monitoring well	

Was a chemical/bacteriological sample submitted to Department? Yes No; If yes, mo/day/yr sample was submitted

Water Well Disinfected? Yes No

5 TYPE OF BLANK CASING USED:		5 Wrought iron	8 Concrete tile	CASING JOINTS: Glued Clamped	
1 Steel	3 RMP (SR)	6 Asbestos-Cement	9 Other (specify below)	Welded	
2 <u>PVC</u>	4 ABS	7 Fiberglass		Threaded	
Blank casing diameter	5 in. to 73	ft. Dia	in. to	ft. Dia	in. to
Casing height above land surface	12	in., weight	2.8	lbs./ft. Wall thickness or gauge No.	Sch. 40
TYPE OF SCREEN OR PERFORATION MATERIAL:					
1 Steel	3 Stainless steel	5 Fiberglass	7 PVC	10 Asbestos-cement	
2 Brass	4 Galvanized steel	6 Concrete tile	8 <u>RMP (SR)</u>	11 Other (specify)	
			9 ABS	12 None used (open hole)	
SCREEN OR PERFORATION OPENINGS ARE:					
1 Continuous slot	3 Mill slot	5 Gauzed wrapped	8 <u>Saw cut</u>	11 None (open hole)	
2 Louvered shutter	4 Key punched	6 Wire wrapped	9 Drilled holes		
		7 Torch cut	10 Other (specify)		
SCREEN-PERFORATED INTERVALS:					
From	73	ft. to	93	ft. From	ft. to
		ft. to		ft. From	ft. to
GRAVEL PACK INTERVALS:					
From	24	ft. to	93	ft. From	ft. to
		ft. to		ft. From	ft. to

6] GROUT MATERIAL:		1 Neat cement	2 Cement grout	<u>3 Bentonite</u>	4 Other
Grout intervals:		From... <u>0</u>	ft. to <u>24</u>	ft. From	ft. to
What is the nearest source of possible contamination:					
1 Septic tank	4 Lateral lines	7 Pit privy	10 Livestock pens	14 Abandoned water well	
2 Sewer lines	5 Cess pool	8 Sewage lagoon	11 Fuel storage	<u>15 Oil well/Gas well</u>	
3 Watertight sewer lines	6 Seepage pit	9 Feedyard	12 Fertilizer storage	16 Other (specify below)	
			13 Insecticide storage		
Direction from well? <u>Southwest</u>			How many feet?	<u>120</u>	

[illegible]

7 CONTRACTOR'S OR LANDOWNER'S CERTIFICATION: This water well was (1) constructed, (2) reconstructed, or (3) plugged under my jurisdiction and was completed on (mo/day/year) 3-24-98 and this record is true to the best of my knowledge and belief. Kansas Water Well Contractor's License No. 186 This Water Well Record was completed on (mo/day/yr) 3-29-98 under the business name of Kelly's Water Well Service, Inc. by (signature) Kathleen L. Wood