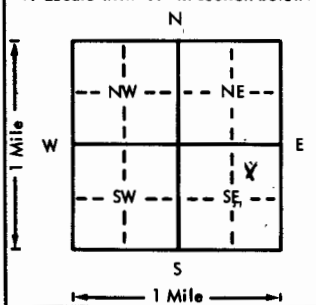


USE TYPEWRITER OR BALL
POINT PEN-PRESS FIRMLY,
PRINT CLEARLY.

WATER WELL RECORD
KSA 82a-1201-1215

Kansas Department of Health and
Environment-Division of Environment
(Water well Contractors)
Topeka, Kansas 66620

1. Location of well: County <u>Stafford</u> Fraction <u>Center 1/4 NE 1/4 SE 1/4</u> Section number <u>3</u> Township number <u>T 25 S R 15</u> Range number <u>EW</u>	
2. Distance and direction from nearest town or city: <u>3 South Maple 1 1/2 miles</u>	
3. Owner of well: <u>Thompson Trucking Inc.</u> R.R. or street: <u>South Oak center</u> City, state, zip code: <u>Great Bend Kans.</u>	
4. Locate with "X" in section below: Sketch map: 	
5. Type and color of material	
6. Bore hole dia. <u>2</u> in. Completion date <u>7-13-76</u> Well depth <u>85</u> ft.	
7. <u>Rotary</u> Cable tool <u>Rotary</u> Driven <u>Dug</u> <u>Hollow rod</u> Jetted <u>Bored</u> Reverse rotary	
8. Use: <u>Domestic</u> Public supply <u>Industry</u> <u>Irrigation</u> Air conditioning <u>Stock</u> <u>Lawn</u> <u>Oil field water</u> Other	
9. Casing: Material <u>PVC</u> Weight: Above or below Threaded <u>Welded</u> Surface <u>1 1/2</u> in. RMP <u>PVC</u> Weight <u>7.6</u> lbs./ft. Dia. <u>2</u> in. to <u>85</u> ft. depth Wall Thickness: inches or Dia. <u>2</u> in. to <u>85</u> ft. depth gage No. <u>154</u>	
10. Screen: Manufacturer's name <u>Shurtz</u> Type <u>Slot</u> Dia. <u>2</u> Slot/gauze <u>1/8</u> Length <u>10</u> Set between <u>875</u> ft. and <u>85</u> ft. Gravel pack? <u>X</u> Size range of material <u>1/4 - 1/2</u>	
11. Static water level: <u>12</u> ft. below land surface Date <u>7-13-76</u>	
12. Pumping level below land surfaces: <u>20</u> ft. after <u>1</u> hrs. pumping <u>80</u> g.p.m. <u> </u> ft. after <u> </u> hrs. pumping <u> </u> g.p.m. Estimated maximum yield <u>100</u> g.p.m.	
13. Water sample submitted: <u>Yes</u> <u>X</u> No Date <u> </u>	
14. Well head completion: <u>12</u> inches above grade	
15. Well grouted? <u>X</u> With: <u>Neat cement</u> <u>1</u> Bentonite <u>Concrete</u> Depth: From <u>0</u> ft. to <u>10</u> ft.	
16. Nearest source of possible contamination: ft. <u> </u> Direction <u> </u> Type <u> </u> Well disinfected upon completion? <u>Yes</u> <u>No</u>	
17. Pump: <u>Not installed</u> Manufacturer's name <u> </u> Model number <u> </u> HP <u> </u> Volts <u> </u> Length of drop pipe <u> </u> ft. capacity <u> </u> g.p.m. Type: <u>Submersible</u> <u>Turbine</u> <u>Jet</u> <u>Reciprocating</u> <u>Centrifugal</u> <u>Other</u>	
18. Elevation: 19. Remarks:	
20. Water well contractor's certification: This well was drilled under my jurisdiction and this report is true to the best of my knowledge and belief. <u>Thompson Trucking Inc.</u> Business name <u>Thompson Trucking Inc.</u> License No. <u>143</u> Address <u>Great Bend Kans.</u> Signed <u> </u> Date <u>7-13</u> Authorized representative	