


USE TYPEWRITER OR BALL POINT PEN-PRESS FIRMLY, PRINT CLEARLY.

WATER WELL RECORD  
KSA 82a-1201-1215

Kansas Department of Health and Environment-Division of Environment (Water well Contractors) Topeka, Kansas 66620

Location of well:  County: Stafford Fraction: C 1/4 NE 1/4 NE 1/4 Section number: 9 Township number: T 25-S S Range number: R 13-E/W E/W

2. Distance and direction from nearest town or city: 2 miles West Side Street address of well location if in city: Bobbie  
3. Owner of well: Stirling Drilling Co R.R. or street: Stirling Drilling Co City, state, zip code: Stirling Kansas

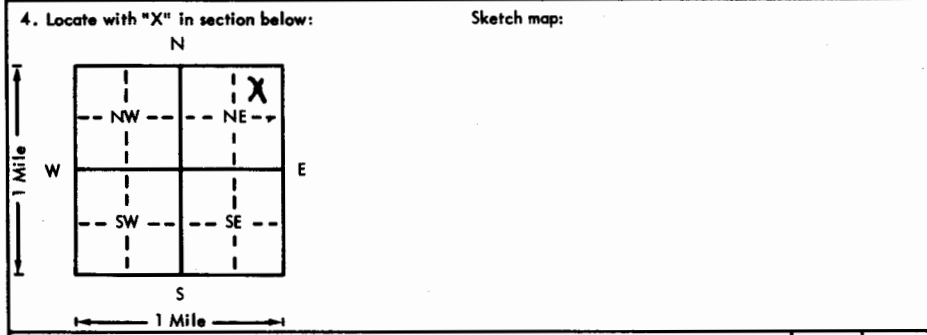

Bore hole dia. 4 in. Completion date 12-3-76  
Well depth 75 ft.  
7.  Cable tool  Rotary  Driven  Dug  
 Hollow rod  Jetted  Bored  Reverse rotary  
8. Use:  Domestic  Public supply  Industry  
 Irrigation  Air conditioning  Stock  
 Lawn  Oil field water  Other  
9. Casing: Material SPC Height: Above or below  
Threaded  Welded  Surface 12 in.  
RMP  PVC  Weight 287.3 lbs./ft.  
Dia. 5 in. to 25 ft. depth Wall Thickness: inches or  
Dia.  in. to  ft. depth Gauge No. 1265

5. Type and color of material	From	To
<u>Clay</u>	<u>0</u>	<u>20</u>
<u>Fine sand</u>	<u>20</u>	<u>40</u>
<u>Clay</u>	<u>40</u>	<u>55</u>
<u>gravel</u>	<u>55</u>	<u>75</u>

10. Screen: Manufacturer's name Meyer Water Well  
Type 5 Slot Dia. 5  
Slot/gauze 1/2 Length 30  
Set between 855 ft. and 75 ft.  
ft. and    ft.  
Gravel pack?  Size range of material 5-1/4  
11. Static water level: 18 ft. below land surface Date 6-5-76 mo./day/yr.  
12. Pumping level below land surfaces:  
22 ft. after 30 hrs. pumping 80 g.p.m.  
   ft. after    hrs. pumping    g.p.m.  
Estimated maximum yield 150 g.p.m.  
13. Water sample submitted:    mo./day/yr.  
 Yes  No Date     
14. Well head completion: 12 inches above grade  
 Pitless adapter  
15. Well grouted?   
With:  Neat cement  Bentonite  Concrete  
Depth: From 0 ft. to 20 ft.  
16. Nearest source of possible contamination:    Direction    Type     
Well disinfected upon completion?  Yes  No  
17. Pump:  Not installed  
Manufacturer's name     
Model number    HP    Volts     
Length of drop pipe    ft. capacity    g.p.m.  
Type:  
 Submersible  Turbine  
 Jet  Reciprocating  
 Centrifugal  Other

18. Elevation: Topography:  Hill  Slope  Upland  Valley  
19. Remarks: (Use a second sheet if needed)

Water well contractor's certification:  
This well was drilled under my jurisdiction and this report is true to the best of my knowledge and belief.  
Business name: Meyer Water Well Service License No. 743  
Address: York Blvd  
Signed: [Signature] Date: 12-3-76  
Authorized representative

T 25 S R 13 E Sec 9 NW NE