

USE TYPEWRITER OR BALL POINT PEN-PRESS FIRMLY, PRINT CLEARLY.


WATER WELL RECORD
KSA 82a-1201-1215

Kansas Department of Health and Environment-Division of Environment (Water well Contractors) Topeka, Kansas 66620

O Sullivan #1

1. Location of well: County Stafford Fraction NE 1/4 NE 1/4 NE 1/4 Section number 10 Township number T 25 S Range number R. 15 W

2. Distance and direction from nearest town or city: 1/2 mi east 3. Owner of well: Sterling Drilling
Street address of well location if in city: 1/4 south of Mapleville or street: Sterling Kansas
City, state, zip code: Sterling Kansas

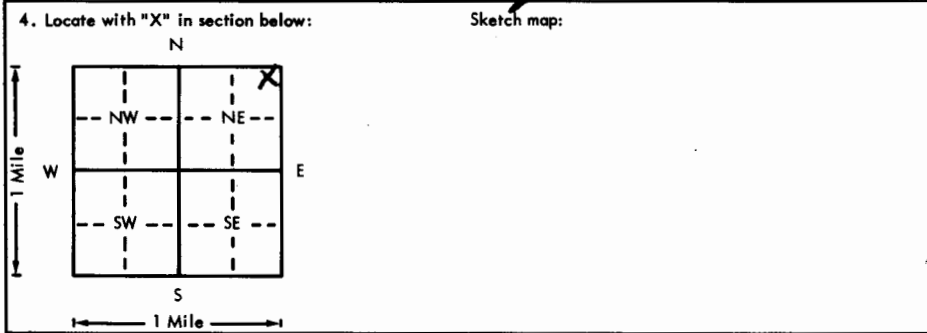

6. Bore hole dia. 8 in. Completion date 12-10-75
Well depth 80 ft.
7. Cable tool Rotary Driven Dug
 Hollow rod Jetted Bored Reverse rotary
8. Use: Domestic Public supply Industry
 Irrigation Air conditioning Stock
 Lawn Oil field water Other
9. Casing: Material Plastic Weight: Above or below
Threaded Welded Surface 12 in.
RMP PVC Weight 287.3 lbs./ft.
Dia. 5 in. to 80 ft. depth Well Thickness: inches or
Dia. 5 in. to 80 ft. depth gage No. 1265

5. Type and color of material

	From	To
<u>Clay</u>	<u>0</u>	<u>12</u>
<u>Sandy clay</u>	<u>12</u>	<u>30</u>
<u>Sand</u>	<u>30</u>	<u>60</u>
<u>Gravel</u>	<u>60</u>	<u>80</u>

10. Screen: Manufacturer's name Seessless Plastic
Type PVC Dia. 5
Slot/gauze 5 Length 20
Set between 60 ft. and 80 ft.
ft. and 80 ft.
Gravel pack? yes Size range of material 1/4 - 1/2
11. Static water level: 15 ft. below land surface Date 12-10-75 mo./day/yr.
12. Pumping level below land surfaces:
____ ft. after ____ hrs. pumping ____ g.p.m.
____ ft. after ____ hrs. pumping ____ g.p.m.
Estimated maximum yield ____ g.p.m.
13. Water sample submitted: ____ mo./day/yr.
Yes No Date ____
14. Well head completion: 12 inches above grade
____ Pitless adapter
15. Well grouted? yes
With: ____ Neat cement Bentonite ____ Concrete
Depth: From 0 ft. to 10 ft.
16. Nearest source of possible contamination None
ft. ____ Direction ____ Type ____
Well disinfected upon completion? ____ Yes ____ No
17. Pump: Not installed
Manufacturer's name ____
Model number ____ HP ____ Volts ____
Length of drop pipe ____ ft. capacity ____ g.p.m.
Type:
____ Submersible ____ Turbine
____ Jet ____ Reciprocating
____ Centrifugal ____ Other

18. Elevation:

Topography:
 Hill
 Slope
 Upland
 Valley

19. Remarks:

20. Water well contractor's certification:
This well was drilled under my jurisdiction and this report is true to the best of my knowledge and belief.
Business name Amys Water well 143 License No. 143
Address Headband, KS
Signed Daryl A. Myers Date 12-10-75
Authorized representative

R 25 T 15 S R 10 Sec 10