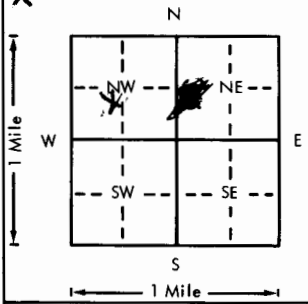


USE TYPEWRITER OR BALL
POINT PEN-PRESS FIRMLY,
PRINT CLEARLY.

WATER WELL RECORD
KSA 82a-1201-1215

Kansas Department of Health and
Environment-Division of Environment
(Water well Contractors)
Topeka, Kansas 66620

1. Location of well:		County <u>Stafford</u>	Fraction <u>NE 1/4 SW 1/4 NW 1/4</u>	Section number <u>11</u>	Township number T <u>25</u> S	Range number R <u>15</u> E <u>W</u>
2. Distance and direction from nearest town or city: <u>4 1/2 SOUTH EASTSIDE MAXVILLE 1505</u>				3. Owner of well: <u>Huskey Delp</u> R.R. or street: <u>800 Duffin Rd</u> City, state, zip code: <u>Wichita KS 67202</u>		
X. Locate with "X" in section below:		Sketch map:		6. Bore hole dia. <u>9</u> in. Completion date Well depth <u>75</u> ft. <u>1-6-79</u>		
				7. ☐ Cable tool ☒ Rotary ☐ Driven ☐ Dug ☐ Hollow rod ☐ Jetted ☐ Bored ☐ Reverse rotary		
				8. Use: ☐ Domestic ☐ Public supply ☐ Industry ☐ Irrigation ☐ Air conditioning ☐ Stock ☐ Lawn ☒ Oil field water ☐ Other		
5. Type and color of material				From	To	9. Casing: Material ☐ Height: Above or below Threaded ☐ Welded ☒ Surface <u>12</u> in. RMP ☐ PVC ☒ Weight <u>278-3</u> lbs./ft. Dia. <u>5</u> in. to <u>25</u> ft. depth ☒ Wall thickness: <u>1/8</u> in. or Dia. <u>5</u> in. to <u>25</u> ft. depth ☐ gage No. <u>200, 265</u>
						10. Screen: Manufacturer's name <u>Peerless</u> Type <u>Saw</u> Dia. <u>5</u> Slot/gauze <u>28</u> Length <u>20</u> Set between <u>75</u> ft. and <u>55</u> ft. ft. and <u>55</u> ft. Gravel pack? ☒ Size range of material <u>14-18</u>
						11. Static water level: <u>25</u> ft. below land surface Date <u>1-6-79</u> mo./day/yr.
						12. Pumping level below land surfaces: ft. after <u> </u> hrs. pumping <u> </u> g.p.m. ft. after <u> </u> hrs. pumping <u> </u> g.p.m. Estimated maximum yield <u> </u> g.p.m.
						13. Water sample submitted: <u> </u> mo./day/yr. Yes ☐ No ☒ Date <u> </u>
						14. Well head completion: <u>12</u> inches above grade ☐ Pitless adapter
						15. Well grouted? ☒ With: ☐ Neat cement ☒ Bentonite ☐ Concrete Depth: From <u>0</u> ft. to <u>10</u> ft.
						16. Nearest source of possible contamination: ft. <u> </u> Direction <u> </u> Type <u>None</u> Well disinfected upon completion? ☐ Yes ☒ No
						17. Pump: ☒ Not installed Manufacturer's name <u> </u> Model number <u> </u> HP <u> </u> Volts <u> </u> Length of drop pipe <u> </u> ft. capacity <u> </u> g.p.m. Type: ☐ Submersible ☐ Turbine ☐ Jet ☐ Reciprocating ☐ Centrifugal ☐ Other
(Use a second sheet if needed)						
18. Elevation:		19. Remarks:		20. Water well contractor's certification: This well was drilled under my jurisdiction and this report is true to the best of my knowledge and belief. <u>Myers Water Well</u> <u>143</u> Business name License No. Address <u>Great Bend KS</u> Signed <u>Deloyd Rosendall</u> Date <u>1-6-79</u> Authorized representative		
Topography: ☐ Hill ☒ Slope ☐ Upland ☐ Valley						