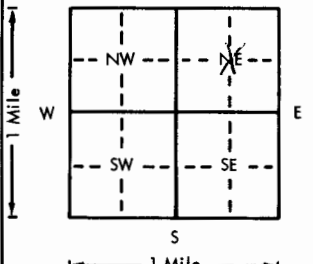


USE TYPEWRITER OR BALL POINT PEN-PRESS FIRMLY, PRINT CLEARLY.

WATER WELL RECORD
KSA 82a-1201-1215

Kansas Department of Health and Environment-Division of Environment
(Water well Contractors)
Topeka, Kansas 66620

1. Location of well: County <u>Stafford</u>		Fraction <u>1/4 C 1/4 NE 1/4</u>		Section number <u>17</u>		Township number T <u>25</u> S R <u>15</u> E <u>N</u>		Range number	
2. Distance and direction from nearest town or city: <u>75-2 W - 129 Macksville Mo.</u> Street address of well location if in city: <u>Mo.</u>				3. Owner of well: <u>Beef Killings</u> R.R. or street: <u>2703 1700 Kinley</u> City, state, zip code: <u>Great Bend, Mo.</u>					
4. Locate with "X" in section below: N  W E S 1 Mile				Sketch map:		6. Bore hole dia. <u>29</u> in. Completion date <u>9-4-76</u> Well depth <u>168</u> ft.			
5. Type and color of material				From		To		7. <input type="checkbox"/> Cable tool <input checked="" type="checkbox"/> Rotary <input type="checkbox"/> Driven <input type="checkbox"/> Dug <input type="checkbox"/> Hollow rod <input type="checkbox"/> Jetted <input type="checkbox"/> Bored <input type="checkbox"/> Reverse rotary	
				8. Use: <input type="checkbox"/> Domestic <input type="checkbox"/> Public supply <input type="checkbox"/> Industry <input checked="" type="checkbox"/> Irrigation <input type="checkbox"/> Air conditioning <input type="checkbox"/> Stock <input type="checkbox"/> Lawn <input type="checkbox"/> Oil field water <input type="checkbox"/> Other					
Sandy top soil Gray Brown Clay Gray clay Sand + gravel clay mixed Sand + gravel some clay Cemented sand Brown + white clay Sand + gravel brown clay gray clay some sand + gravel Sand + gravel				From		To		9. Casing: Material <u>Steel</u> Height: <u>Above</u> or below Threaded <input type="checkbox"/> Welded <input checked="" type="checkbox"/> Surface <u>14</u> in. RMP <input type="checkbox"/> PVC <input type="checkbox"/> Weight <input type="checkbox"/> lbs./ft. Dia. <u>14</u> in. to <u>168</u> ft. depth Wall Thickness: inches or Dia. <input type="checkbox"/> in. to <input type="checkbox"/> ft. depth gage No. <u>79 C</u>	
				10. Screen: Manufacturer's name <u>Acerra</u> Type <u>slut</u> Dia. <u>16</u> Slot/gauge <u>3/16</u> Length <u>40</u> Set between <u>128</u> ft. and <u>168</u> ft. <input type="checkbox"/> ft. and <input type="checkbox"/> ft. Gravel pack? <input checked="" type="checkbox"/> Size range of material <u>3/4-1/2"</u>					
18. Elevation:				19. Remarks:		11. Static water level: <u>22</u> ft. below land surface Date <u>9/8-76</u> mo./day/yr.			
						12. Pumping level below land surfaces: <input type="checkbox"/> ft. after <input type="checkbox"/> hrs. pumping <input type="checkbox"/> g.p.m. <input type="checkbox"/> ft. after <input type="checkbox"/> hrs. pumping <input type="checkbox"/> g.p.m. Estimated maximum yield <input type="checkbox"/> g.p.m.			
Topography: <input type="checkbox"/> Hill <input checked="" type="checkbox"/> Slope <input type="checkbox"/> Upland <input type="checkbox"/> Valley				20. Water well contractor's certification: This well was drilled under my jurisdiction and this report is true to the best of my knowledge and belief. <u>Resonancey - Benin 130</u> Business name Address <u>Great Bend, Mo.</u> Signed <u>Freddie Nelson</u> Date _____ Authorized representative		13. Water sample submitted: <input checked="" type="checkbox"/> Yes <input type="checkbox"/> No Date <u>9-8-76</u> mo./day/yr.		14. Well head completion: <input type="checkbox"/> Pitless adapter <input type="checkbox"/> Inches above grade	
						15. Well grouted? <input checked="" type="checkbox"/> With: <input checked="" type="checkbox"/> Neat cement <input type="checkbox"/> Bentonite <input checked="" type="checkbox"/> Concrete Depth: From <u>0</u> ft. to <u>10</u> ft.		16. Nearest source of possible contamination: ft. <u>124</u> Direction <u>SW</u> Type <u>Discard</u> Well disinfected upon completion? <input type="checkbox"/> Yes <input type="checkbox"/> No	
(Use a second sheet if needed)				20. Water well contractor's certification: This well was drilled under my jurisdiction and this report is true to the best of my knowledge and belief. <u>Resonancey - Benin 130</u> Business name Address <u>Great Bend, Mo.</u> Signed <u>Freddie Nelson</u> Date _____ Authorized representative		17. Pump: Not installed Manufacturer's name <u>Tracuzzi</u> Model number <u>4-124LS</u> HP <u>3/4</u> Volts _____ Length of drop pipe <u>90</u> ft. capacity <u>800</u> g.p.m. Type: <input type="checkbox"/> Submersible <input checked="" type="checkbox"/> Turbine <input type="checkbox"/> Jet <input type="checkbox"/> Reciprocating <input type="checkbox"/> Centrifugal <input type="checkbox"/> Other			

25
 150
 17
 Sec
 1/4
 1/4
 1/4
 C NE