


USE TYPEWRITER OR BALL POINT PEN-PRESS FIRMLY, PRINT CLEARLY.

WATER WELL RECORD  
KSA 82a-1201-1215

Kansas Department of Health and Environment-Division of Environment (Water well Contractors) Topeka, Kansas 66620

1. Location of well: County Stephens Fraction 1/4 C 1/4 SE 1/4 Section number 17 Township number T 25 S R 15 Range number 15 EW

2. Distance and direction from nearest town or city: 6 1/2 S 1 1/4 W of Mukawillie  
Street address of well location if in city: to  
3. Owner of well: Bill Kabbins  
R.R. or street: 2703 McKinley  
City, state, zip code: Great Bend, KS

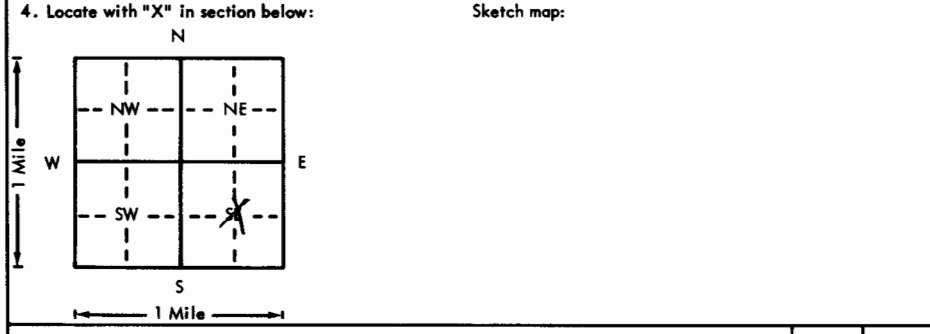

6. Bore hole dia. 2 1/2 in. Completion date 8-17-76  
Well depth 154 ft.  
7. Cable tool  Rotary  Driven  Dug  
 Hollow rod  Jetted  Bored  Reverse rotary  
8. Use:  Domestic  Public supply  Industry  
 Irrigation  Air conditioning  Stock  
 Lawn  Oil field water  Other  
9. Casing: Material Steel Height: Above or below  
Threaded  Welded  Surface 18 in.  
RMP  PVC  Weight          lbs./ft.  
Dia. 1 1/2 in. to 154 ft. depth; Wall Thickness: inches or  
Dia.          in. to          ft. depth; gage No. 79a

5. Type and color of material	From	To
<u>Sandy top soil</u>	<u>0</u>	<u>3</u>
<u>Brown + gray clay</u>	<u>3</u>	<u>16</u>
<u>fine sand + gray clay</u>	<u>16</u>	<u>36</u>
<u>Sand + gravel medium</u>	<u>36</u>	<u>53</u>
<u>Brown clay</u>	<u>53</u>	<u>55</u>
<u>Sand + gravel clean coarse</u>	<u>55</u>	<u>73</u>
<u>yellow brown clay + rock</u>	<u>73</u>	<u>80</u>
<u>Sand + gravel clean coarse</u>	<u>80</u>	<u>82</u>
<u>Brown + white clay, some hard rock</u>	<u>82</u>	<u>103</u>
<u>Sand + gravel medium coarse</u>	<u>103</u>	<u>109</u>
<u>Brown clay</u>	<u>109</u>	<u>110</u>
<u>Sand + gravel clean coarse</u>	<u>110</u>	<u>119</u>
<u>Sand + gravel w/clay streaks</u>	<u>119</u>	<u>122</u>
<u>Sand + gravel clean, coarse</u>	<u>122</u>	<u>154</u>
<u>Hard white rock</u>	<u>154</u>	

10. Screen: Manufacturer's name Wells  
Type slotted Dia. 1 1/2  
Slot 3/16 Length 100  
Set between 54 ft. and 154 ft.  
         ft. and          ft.  
Gravel pack?  Size range of material 1/4-3/4  
11. Static water level: 15 ft. below land surface Date 4-26-76 mo./day/yr.  
12. Pumping level below land surface:  
         ft. after          hrs. pumping          g.p.m.  
         ft. after          hrs. pumping          g.p.m.  
Estimated maximum yield          g.p.m.  
13. Water sample submitted:          mo./day/yr.  
 Yes  No Date           
14. Well head completion:  
 Pitless adapter          inches above grade  
15. Well grouted?   
With:  Neat cement  Bentonite  Concrete  
Depth: From          ft. to          ft.  
16. Nearest source of possible contamination:  
ft. 2 mi Direction N Type Gas well  
Well disinfected upon completion?  Yes  No  
17. Pump:  Not installed  
Manufacturer's name Galuzzi  
Model number 4-1525 HP 20 Volts           
Length of drop pipe 80 ft. capacity 200 g.p.m.  
Type:  
 Submersible  Turbine  
 Jet  Reciprocating  
 Centrifugal  Other

18. Elevation: Topography:  Hill  Slope  Upland  Valley  
19. Remarks: (Use a second sheet if needed)

20. Water well contractor's certification:  
This well was drilled under my jurisdiction and this report is true to the best of my knowledge and belief.  
Kasnerantz Benis 134  
Business name          License No.           
Address Great Bend, KS  
Signed Fredia Ordan Date 9/10/76  
Authorized representative

T 25 S R 15 E S 17 C SE