

1 LOCATION OF WATER WELL:	Fraction	Section Number	Township Number	Range Number
County: Stafford	NE ¼ SE ¼ NW ¼	19	T 25 S	R 15 E (W)


Distance and direction from nearest town or city street address of well if located within city?

Approximately 5 1/2 South 1 1/2 West of Macksville KS

2 WATER WELL OWNER: Jim Piland
RR#, St. Address, Box # : Rt. 2
City, State, ZIP Code : Macksville, KS 67557

Board of Agriculture, Division of Water Resources
Application Number: N/A

3	LOCATE WELL'S LOCATION WITH AN "X" IN SECTION BOX:	4	DEPTH OF COMPLETED WELL.....65.....	ft.	ELEVATION: ..unknown.....
			Depth(s) Groundwater Encountered: 1	ft	2

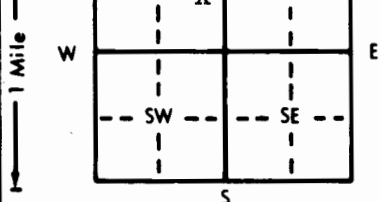

4 DEPTH OF COMPLETED WELL... 65 ft. ELEVATION: .. unknown

Depth(s) Groundwater Encountered 1. ft. 2. ft. 3. ft.

WELL'S STATIC WATER LEVEL ... 21. ft. below land surface measured on mo/day/yr

Pump test data: Well water was not ch'd. ft. after hours pumping gpm

Est. Yield unknown gpm: Well water was ft. after hours pumping gpm

Bore Hole Diameter... 9 in. to 65 ft., and in. to ft.

WELL WATER TO BE USED AS:

1 Domestic	3 Feedlot	6 Oil field water supply	9 Dewatering	11 Injection well
2 Irrigation	4 Industrial	7 Lawn and garden only	10 Monitoring well	12 Other (Specify below)

Was a chemical/bacteriological sample submitted to Department? Yes.....No. X.....; If yes, mo/day/yr sample was submitted

Water Well Disinfected? Yes X No

5	TYPE OF BLANK CASING USED:		5 Wrought iron	8 Concrete tile	CASING JOINTS: Glued . . ☒ . . Clamped Welded Threaded
	1 Steel	3 RMP (SR)	6 Asbestos-Cement	9 Other (specify below)	
	2 PVC	4 ABS	7 Fiberglass		

Blank casing diameter . . . 5 . . . in. to . . . 55 . . . ft., Dia . . . in. to . . . ft., Dia . . . in. to . . . ft.
Casing height above land surface . . . 24 . . . in., weight . . . 2.277 . . . lbs./ft. Wall thickness or gauge No. . . 214

TYPE OF SCREEN OR PERFORATION MATERIAL:				
1 Steel	3 Stainless steel	5 Fiberglass	7 PVC	10 Asbestos-cement
2 Brass	4 Galvanized steel	6 Concrete tile	8 RMP (SR)	11 Other (specify)
			9 ABS	12 None used (open hole)

SCREEN OR PERFORATION OPENINGS ARE:

1 Continuous slot	3 Mill slot	5 Gauzed wrapped	8 Saw cut	11 None (open hole)
2 Louvered shutter	4 Key punched	6 Wire wrapped	9 Drilled holes	
		7 Torch cut	10 Other (specify)	

SCREEN-PERFORATED INTERVALS:	From 55	ft. to 65	ft., From	ft. to	ft.
	From	ft. to	ft., From	ft. to	ft.
GRAVEL PACK INTERVALS:	From 39	ft. to 65	ft., From	ft. to	ft.
Cuttings -	From 20	ft. to 37	ft., From	ft. to	ft.

6	GROUT MATERIAL:		1 Neat cement	2 Cement grout	3 Bentonite	4 Other	Bentonite hole plug
	Grout Intervals:	From	5	ft. to	20	ft.	From 37 ft. to 39 ft.

What is the nearest source of possible contamination:			10 Livestock pens	14 Abandoned water well
1 <u>Septic tank</u>	4 Lateral lines	7 Pit privy	11 Fuel storage	15 Oil well/Gas well
2 <u>Sewer lines</u>	5 Cess pool	8 Sewage lagoon	12 Fertilizer storage	16 Other (specify below)
3 Watertight sewer lines	6 Seepage pit	9 Feedyard	13 Insecticide storage	

Direction from well? North East How many feet? 100'

[illegible]

7 CONTRACTOR'S OR LANDOWNER'S CERTIFICATION: This water well was (1) constructed, (2) reconstructed, or (3) plugged under my jurisdiction and was completed on (mo/day/year) 3/8/89 and this record is true to the best of my knowledge and belief. Kansas Water Well Contractor's License No. 185 This Water Well Record was completed on (mo/day/yr) 3/9/89 under the business name of Clarke Well & Equipment, Inc. by (signature) James W. Clarke