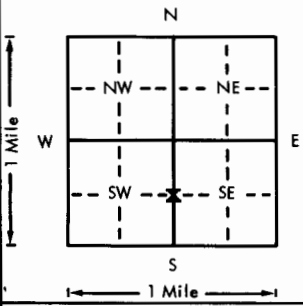


USE TYPEWRITER OR BALL
POINT PEN-PRESS FIRMLY,
PRINT CLEARLY.

WATER WELL RECORD
KSA 82a-1201-1215

Kansas Department of Health and
Environment-Division of Environment
(Water well Contractors)
Topeka, Kansas 66620

1. Location of well:	County Stafford	Fraction Center of S $\frac{1}{2}$ XX XX XX	Section number 25	Township number T 25	Range number S R 15	E W
2. Distance and direction from nearest town or city: 10 miles southeast of Macksville, KS Street address of well location if in city:			3. Owner of well: Don Neeland R.R. or street: Route 3 City, state, zip code: Great Bend, KS 67530			
4. Locate with "X" in section below: 			Sketch map:			
5. Type and color of material			From	To		
6. Bore hole dia. 24 in. Completion date 8-17-77 Well depth 88 ft.			7. ☐ Cable tool ☐ Rotary ☐ Driven ☐ Dug ☐ Hollow rod ☐ Jetted ☐ Bored ☒ Reverse rotary			
8. Use: ☐ Domestic ☐ Public supply ☐ Industry ☒ Irrigation ☐ Air conditioning ☐ Stock ☐ Lawn ☐ Oil field water ☐ Other			9. Casing: Material Steel Height: above or below Threaded ☐ Welded ☒ Surface 12 in. RMP ☐ PVC ☐ Weight 30.3 lbs./ft. Dia. 16 in. to 48 ft. depth Wall Thickness: inches or Dia. ☐ in. to ☐ ft. depth gage No. 7 ga.			
10. Screen: Manufacturer's name Doerr Type Double-slot Dia. 16" Slot/gauze 1/8" Length 40' Set between 48 ft. and 88 ft. ft. and ☐ ft. Gravel pack? Yes Size range of material CM-7			11. Static water level: ☐ mo./day/yr. 8 ft. below land surface Date 7-28-77			
12. Pumping level below land surfaces: N/C ft. after ☐ hrs. pumping ☐ g.p.m. ft. after ☐ hrs. pumping ☐ g.p.m. Estimated maximum yield ☐ g.p.m.			13. Water sample submitted: ☐ mo./day/yr. Yes ☒ No Date ☐			
14. Well head completion: ☐ Pitless adapter 12 Inches above grade			15. Well grouted? Yes With: ☒ Neat cement ☐ Bentonite ☐ Concrete Depth: From 0 ft. to 10 ft.			
16. Nearest source of possible contamination: Field ft. ☐ Direction ☐ Type ☐ Well disinfected upon completion? ☐ Yes ☐ No			17. Pump: ☐ Not installed Manufacturer's name Peerless Pump Co. Model number 12MB-3 HP 80 Volts ☐ Length of drop pipe 60 ft. capacity 900 g.p.m. Type: ☐ Submersible ☒ Turbine ☐ Jet ☐ Reciprocating ☐ Centrifugal ☐ Other			
18. Elevation:			19. Remarks:			
Topography: ☐ Hill ☐ Slope ☐ Upland ☐ Valley			PUMP OWNER: F. Bryce Lamb Rural Route Macksville, KS 67557			
			20. Water well contractor's certification: This well was drilled under my jurisdiction and this report is true to the best of my knowledge and belief. Clarke Well & Eq., Inc. 185 Business name License No. Address Great Bend, KS Signed O. W. Clarke Date 8-18-77 Authorized representative			