

Kansas Department of Health and
Environment-Division of Environment
(Water well Contractors)
Topeka, Kansas 66620


County STAFFORD Edwards	Fraction C SE NE $\frac{1}{4}$ $\frac{1}{4}$ $\frac{1}{4}$	Section number 26	Township number 25S	Range number 15W
--	---	-----------------------------	-------------------------------	----------------------------

2. Distance and direction from nearest town or city:
7 1/2 South ~~2 1/2 east~~ 2 east 3/4 North
Street address of well location if in city: Marietta

3. Owner of well: D. R. Louch
R.R. or street: Wichita Kansas
City, state, zip code: 321 S. Broadway

4. Locate with "X" in section below:

Sketch map:

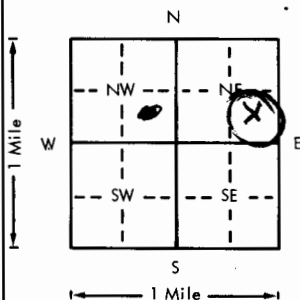

5. Type and color of material

From	To
------	----

Clay
Sandy clay
Clay -
Gravel

0	10
10	15
15	40
40	60

6. Bore hole dia. 9 in. Completion date 11-1-78
Well depth 60 ft.

7. ☐ Cable tool ☒ Rotary ☐ Driven ☐ Dug
☐ Hollow rod ☐ Jetted ☐ Bored ☐ Reverse rotary

8. Use: ☐ Domestic ☐ Public supply ☐ Industry
☐ Irrigation ☐ Air conditioning ☐ Stock
☐ Lawn ☒ Oil field water ☐ Other

9. Casing: Material Plastic Height: Above or below
Threaded _____ Welded X Surface 12 in.
RMP _____ PVC X Weight 2873 lbs./ft.
Dia. 5 in. to 6.6 ft. depth Wall Thickness: inches or
Dia. _____ in. to _____ ft. depth Gage No. 200

10. Screen: Manufacturer's name Self made
Type Pre Dia. 5
Slot/gauze 3 Length 20
Set between 40 ft. and 60 ft.
_____ ft. and _____ ft.
Gravel pack? No Size range of material 5-20

11. Static water level: 6 ft. below land surface Date 11-6-78 mo./day/yr.

12. Pumping level below land surfaces:
 _____ ft. after _____ hrs. pumping _____ g.p.m.
 _____ ft. after _____ hrs. pumping _____ g.p.m.
 Estimated maximum yield _____ g.p.m.

13. Water sample submitted: _____ mo./day/yr.
Yes ☒ No ☐ Date _____

14. Well head completion:
 _____ Pitless adapter _____ inches above grade

15. Well grouted? yes
With: Neat cement ☒ Bentonite ☐ Concrete
Depth: From 0 ft. to 10 ft.

16. Nearest source of possible contamination: _____
ft. _____ Direction _____ Type None
Well disinfected upon completion? _____ Yes 1 No _____

17. Pump: ☒ Not installed

Manufacturer's name _____

Model number _____ HP _____ Volts _____

Length of drop pipe _____ ft. capacity _____ g.p.m.

Type:

☐ Submersible	☐ Turbine
☐ Jet	☐ Reciprocating
☐ Centrifugal	☐ Other

18. Elevation:

19. Remarks:

Topography:

_____ Hill
~~_____~~ Slope
 _____ Upland
 _____ Valley

20. Water well contractor's certification:
This well was drilled under my jurisdiction and this report is true to the best of my knowledge and belief.

myers water well
Business name License No.
Address 91 Bend Ks 143
Signed @myers 11-6-78 Date
Authorized representative