

USE TYPEWRITER OR BALL POINT PEN-PRESS FIRMLY, PRINT CLEARLY.


WATER WELL RECORD  
KSA 82a-1201-1215

Kansas Department of Health and Environment-Division of Environment  
(Water well Contractors)  
Topeka, Kansas 66620

1. Location of well:	County <b>Stafford</b>	Fraction <b>SW 1/4 SE 1/4 SE 1/4</b>	Section number <b>26</b>	Township number <b>T X 25 S</b>	Range number <b>R 15 EW</b>
----------------------	---------------------------	---	-----------------------------	------------------------------------	--------------------------------

2. Distance and direction from nearest town or city:  
**9 1/2 miles Southeast of Macksville, KS**  
Street address of well location if in city:

3. Owner of well: **Fred Grunder**  
(?)  
R.R. or street:  
City, state, zip code: **St. John, KS 67576**

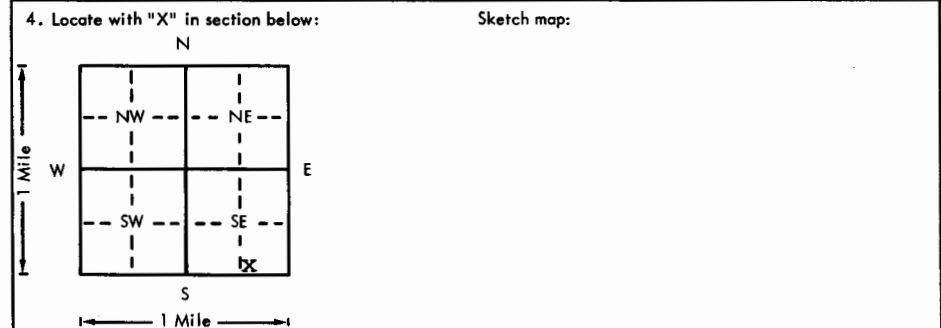

6. Bore hole dia. **2 1/4** in. Completion date **8-1-77**  
Well depth **85** ft.

7.  Cable tool  Rotary  Driven  Dug  
 Hollow rod  Jetted  Bored  Reverse rotary

8. Use:  Domestic  Public supply  Industry  
 Irrigation  Air conditioning  Stock  
 Lawn  Oil field water  Other

9. Casing: Material steel Height Above or below  
Threaded  Welded  Surface 12 in.  
RMP  PVC  Weight 30.3 lbs./ft.  
Dia. 16 in. to 45 ft. depth Wall Thickness: inches or  
Dia.  in. to  ft. depth gage No. 7 ga.

5. Type and color of material	From	To
Top soil & sandy clay	0	8
Sand & gravel	8	34
Yellow clay	34	35
Sand & gravel	35	84
Brown clay	84	85

10. Screen: Manufacturer's name **Doerr**

Type Double-slot Dia. 16"  
Slot/gauge 1/8 Length 40'  
Set between 45 ft. and 85 ft.  
ft. and ft.  
Gravel pack? yes Size range of material 3/8-200

11. Static water level: 7 ft. below land surface Date 6-21-77 mo./day/yr.

12. Pumping level below land surfaces: **N/C**  
ft. after hrs. pumping g.p.m.  
ft. after hrs. pumping g.p.m.  
Estimated maximum yield g.p.m.

13. Water sample submitted: mo./day/yr.  
Yes  No  Date

14. Well head completion:  
 Pitless adapter 12 Inches above grade

15. Well grouted? yes  
With:  Neat cement  Bentonite  Concrete  
Depth: From 0 ft. to 10 ft.

16. Nearest source of possible contamination: **FIELD**  
ft. Direction Type  
Well disinfected upon completion? Yes  No

17. Pump:  Not installed  
Manufacturer's name **Western Land Roller**  
Model number **14"-1 stage** 75 Volts  
Length of drop pipe 50 ft. capacity 1400 g.p.m.  
Type:  
 Submersible  Turbine  
 Jet  Reciprocating  
 Centrifugal  Other

18. Elevation:  
Topography:  
 Hill  
 Slope  
 Upland  
 Valley

19. Remarks:

20. Water well contractor's certification:  
This well was drilled under my jurisdiction and this report is true to the best of my knowledge and belief.  
**Clarke Well & Eq., Inc.** 185  
Business name License No.  
Address **Great Bend, KS 65730**  
Signed *[Signature]* Date **8-3-77**  
Authorized representative

T 25 R 15 SE 26 Sec 1/4 1/4 1/4 1/4

(Use a second sheet if needed)