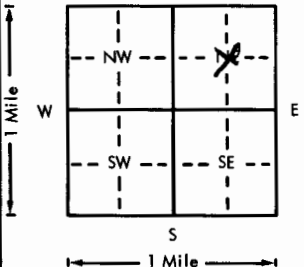


USE TYPEWRITER OR BALL POINT PEN-PRESS FIRMLY, PRINT CLEARLY.

WATER WELL RECORD  
KSA 82a-1201-1215

Kansas Department of Health and Environment-Division of Environment  
(Water well Contractors)  
Topeka, Kansas 66620

*Payton #1*

1. Location of well: County <u>Stafford</u>		Fraction <u>C NE</u> 1/4 1/4 1/4		Section number <u>28</u>	Township number <u>T 25 S</u>	Range number <u>R 15 W</u>
2. Distance and direction from nearest town or city: <u>7 1/4 south</u> Street address of well location if in city: <u>maxville</u>				3. Owner of well: <u>Stirling Drilling Co</u> R.R. or street: <u>Stirling</u> City, state, zip code: <u>Kansas</u>		
4. Locate with "X" in section below: Sketch map: N  W E S 1 Mile				6. Bore hole dia. <u>8</u> in. Completion date <u>6-20-77</u> Well depth <u>60</u> ft.		
5. Type and color of material				7. <input type="checkbox"/> Cable tool <input checked="" type="checkbox"/> Rotary <input type="checkbox"/> Driven <input type="checkbox"/> Dug <input type="checkbox"/> Hollow rod <input type="checkbox"/> Jetted <input type="checkbox"/> Bored <input type="checkbox"/> Reverse rotary		
				8. Use: <input type="checkbox"/> Domestic <input type="checkbox"/> Public supply <input type="checkbox"/> Industry <input type="checkbox"/> Irrigation <input type="checkbox"/> Air conditioning <input type="checkbox"/> Stock <input type="checkbox"/> Lawn <input checked="" type="checkbox"/> Oil field water <input type="checkbox"/> Other		
From To				9. Casing: Material <u>Plastic</u> Height: <input checked="" type="checkbox"/> Above or below Threaded <input type="checkbox"/> Welded <input checked="" type="checkbox"/> Surface <u>12</u> in. RMP <input type="checkbox"/> PVC <input checked="" type="checkbox"/> Weight <u>287.3</u> lbs./ft. Dia. <u>5</u> in. to <u>60</u> ft. depth Wall Thickness: inches or Dia. <u>   </u> in. to <u>   </u> ft. depth gage No. <u>200</u>		
				10. Screen: Manufacturer's name <u>Self made</u> Type <u>PVC</u> Dia. <u>5</u> Slot gauze <u>5</u> Length <u>20</u> Set between <u>5</u> ft. and <u>60</u> ft. <u>40</u> ft. and <u>   </u> ft. Gravel pack? <input checked="" type="checkbox"/> yes Size range of material <u>1/8</u> to <u>1/4</u>		
				11. Static water level: <u>18</u> ft. below land surface Date <u>6-20-77</u> mo./day/yr.		
				12. Pumping level below land surfaces: <u>   </u> ft. after <u>   </u> hrs. pumping <u>   </u> g.p.m. <u>   </u> ft. after <u>   </u> hrs. pumping <u>   </u> g.p.m. Estimated maximum yield <u>   </u> g.p.m.		
				13. Water sample submitted: <u>   </u> mo./day/yr. <input type="checkbox"/> Yes <input checked="" type="checkbox"/> No Date <u>   </u>		
				14. Well head completion: <input type="checkbox"/> Pitless adapter <u>   </u> inches above grade		
				15. Well grouted? <u>yes</u> With: <input type="checkbox"/> Neat cement <input checked="" type="checkbox"/> Bentonite <input type="checkbox"/> Concrete Depth: From <u>6</u> ft. to <u>60</u> ft.		
				16. Nearest source of possible contamination: ft. <u>   </u> Direction <u>   </u> Type <u>   </u> Well disinfected upon completion? <input type="checkbox"/> Yes <input type="checkbox"/> No		
				17. Pump: <input checked="" type="checkbox"/> Not installed Manufacturer's name <u>   </u> Model number <u>   </u> HP <u>   </u> Volts <u>   </u> Length of drop pipe <u>   </u> ft. capacity <u>   </u> g.p.m. Type: <input type="checkbox"/> Submersible <input type="checkbox"/> Turbine <input type="checkbox"/> Jet <input type="checkbox"/> Reciprocating <input type="checkbox"/> Centrifugal <input type="checkbox"/> Other		
				20. Water well contractor's certification: This well was drilled under my jurisdiction and this report is true to the best of my knowledge and belief. <u>Myers Water Well</u> Business name <u>   </u> License No. <u>   </u> Address <u>St Bend Ks 143</u> Signed <u>A Myers</u> Date <u>6-20-77</u> Authorized representative		
18. Elevation:		19. Remarks:				
Topography: <input type="checkbox"/> Hill <input checked="" type="checkbox"/> Slope <input type="checkbox"/> Upland <input type="checkbox"/> Valley						

T 25 S  
 R 15 W  
 Sec 28  
 C NE  
 1/4 1/4 1/4