


1 LOCATION OF WATER WELL:	Fraction	Near Center of	Section Number	Township Number	Range Number
County: <u>Stafford</u>	<u>1/4</u>	<u>1/4 SE 1/4</u>	<u>32</u>	<u>T 25 S</u>	<u>R 15</u> X <u>W</u>

Distance and direction from nearest town or city street address of well if located within city?

Approx. 1 mile north of Hopewell, KS

2 WATER WELL OWNER:	Norman Wood	
RR#, St. Address, Box # :	Route 1	Board of Agriculture, Division of Water Resources
City, State, ZIP Code :	Haviland, KS	Application Number: 38,136

3 LOCATE WELL'S LOCATION WITH AN "X" IN SECTION BOX: 4 DEPTH OF COMPLETED WELL. 94 ft. ELEVATION: unknown

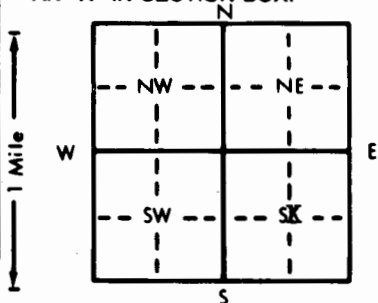

4 DEPTH OF COMPLETED WELL. 94 ft. ELEVATION: unknown
 Depth(s) Groundwater Encountered 1. 10 ft. 2. ft. 3. ft.
 WELL'S STATIC WATER LEVEL 10 ft. below land surface measured on mo/day/yr 12/21/87
 Pump test data: Well water was not ck'd ft. after hours pumping gpm
 Est. Yield 1100 gpm: Well water was ft. after hours pumping gpm
 Bore Hole Diameter. 24 in. to 94 ft., and in. to ft.
 WELL WATER TO BE USED AS: 5 Public water supply 8 Air conditioning 11 Injection well
 1 Domestic 3 Feedlot 6 Oil field water supply 9 Dewatering 12 Other (Specify below)
2 Irrigation 4 Industrial 7 Lawn and garden only 10 Observation well
 Was a chemical/bacteriological sample submitted to Department? Yes No X; If yes, mo/day/yr sample was sub-
 mitted Water Well Disinfected? Yes No X

5 TYPE OF BLANK CASING USED:		5 Wrought iron	8 Concrete tile	CASING JOINTS: Glued Clamped
1 Steel	3 RMP (SR)	6 Asbestos-Cement	9 Other (specify below)	Welded ☒
2 PVC	4 ABS	7 Fiberglass		Threaded

Blank casing diameter 16 . . . in. to . . . 53 . . . ft., Dia . . . in. to . . . ft., Dia . . . in. to . . . ft.
Casing height above land surface 12 . . . in., weight 36.87 . . . lbs./ft. Wall thickness or gauge No. . . 219

TYPE OF SCREEN OR PERFORATION MATERIAL:			7 PVC	10 Asbestos-cement
1 Steel	3 Stainless steel	5 Fiberglass	8 RMP (SR)	11 Other (specify)
2 Brass	4 Galvanized steel	6 Concrete tile	9 ABS	12 None used (open hole)

SCREEN OR PERFORATION OPENINGS ARE:

1 Continuous slot	3 Mill slot	5 Gauzed wrapped	8 Saw cut	11 None (open hole)
2 Louvered shutter	4 Key punched	6 Wire wrapped	9 Drilled holes	
		7 Torch cut	10 Other (specify)	Doerr Bridge Slot

SCREEN-PERFORATED INTERVALS:	From . . . 53 ft. to . . . 93 ft.,	From ft. to ft.
	From ft. to ft.,	From ft. to ft.
GRAVEL PACK INTERVALS:	From . . . 20 ft. to . . . 93 ft.,	From ft. to ft.
	From ft. to ft.,	From ft. to ft.

6 GROUT MATERIAL: 1 Neat cement 2 Cement grout 3 Bentonite 4 Other

Grout Intervals: From 0 ft. to 20 ft., From ft. to ft., From ft. to ft.

What is the nearest source of possible contamination:

1 Septic tank	4 Lateral lines	7 Pit privy	10 Livestock pens	14 Abandoned water well
2 Sewer lines	5 Cess pool	8 Sewage lagoon	11 Fuel storage	15 Oil well/Gas well
3 Watertight sewer lines	6 Seepage pit	9 Feedyard	12 Fertilizer storage	16 Other (specify below)
Direction from well?	all		13 Insecticide storage	FIELD/No. Known Source..
			How many feet?	

[illegible]

7 CONTRACTOR'S OR LANDOWNER'S CERTIFICATION: This water well was (1) constructed, (2) reconstructed, or (3) plugged under my jurisdiction and was completed on (mo/day/year) 12/21/87 and this record is true to the best of my knowledge and belief. Kansas Water Well Contractor's License No. 185 This Water Well Record was completed on (mo/day/yr) 12/22/87 under the business name of Clarke Well & Equipment, Inc. by (signature) [Signature]