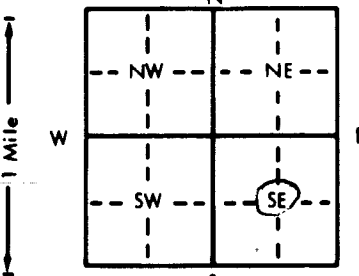


1 LOCATION OF WATER WELL: County: Edwards Fraction center 1/4 NC 1/4 SE 1/4 Section Number 3 Township Number T 25 S Range Number R 16 EW

Distance and direction from nearest town or city street address of well if located within city?  
X 3 1/2 miles south, 1 3/4 miles east, 1/4 north of Belpre, KS

2 WATER WELL OWNER: ~~MAN~~ Maloy Breitenbach RR#, St. Address, Box #: 2209 Cleveland Board of Agriculture, Division of Water Resources City, State, ZIP Code: Great Bend, KS 67530 Application Number: 37,593

3 LOCATE WELL'S LOCATION WITH AN "X" IN SECTION BOX:  4 DEPTH OF COMPLETED WELL: 141 ft. ELEVATION: unknown  
 Depth(s) Groundwater Encountered 1. 28 ft. 2. 28 ft. 3. ft.  
 WELL'S STATIC WATER LEVEL: ft. below land surface measured on mo/day/yr  
 Pump test data: Well water was NOT ch'd. ft. after hours pumping gpm  
 Est. Yield gpm: Well water was ft. after hours pumping gpm  
 Bore Hole Diameter: .24 in. to .140 ft., and in. to ft.  
 WELL WATER TO BE USED AS: 5 Public water supply 8 Air conditioning 11 Injection well  
 1 Domestic 3 Feedlot 6 Oil field water supply 9 Dewatering 12 Other (Specify below)  
 2 Irrigation 4 Industrial 7 Lawn and garden only 10 Monitoring well  
 Was a chemical/bacteriological sample submitted to Department? Yes.....No...X.....; If yes, mo/day/yr sample was submitted  
 Water Well Disinfected? Yes No X

5 TYPE OF BLANK CASING USED: 1 Steel 3 RMP (SR) 5 Wrought iron 8 Concrete tile CASING JOINTS: Glued Clamped  
 2 PVC 4 ABS 6 Asbestos-Cement 9 Other (specify below) Welded X  
 7 Fiberglass Threaded  
 Blank casing diameter: 16 in. to 141 ft., Dia. in. to ft., Dia. in. to ft.  
 Casing height above land surface: 12 in., weight 42.05 lbs./ft. Wall thickness or gauge No. 250  
 TYPE OF SCREEN OR PERFORATION MATERIAL: 1 Steel 3 Stainless steel 5 Fiberglass 8 RMP (SR) 10 Asbestos-cement  
 2 Brass 4 Galvanized steel 6 Concrete tile 9 ABS 11 Other (specify)  
 12 None used (open hole)  
 SCREEN OR PERFORATION OPENINGS ARE: 1 Continuous slot 3 Mill slot 5 Gauzed wrapped 8 Saw cut 11 None (open hole)  
 2 Louvered shutter 4 Key punched 6 Wire wrapped 9 Drilled holes  
 7 Torch cut 10 Other (specify) Doerr Slot  
 SCREEN-PERFORATED INTERVALS: From 101 ft. to 141 ft., From ft. to ft.  
 From ft. to ft., From ft. to ft.  
 GRAVEL PACK INTERVALS: From 20 ft. to 140 ft., From ft. to ft.  
 From ft. to ft., From ft. to ft.

6 GROUT MATERIAL: 1 Neat cement 2 Cement grout 3 Bentonite 4 Other  
 Grout intervals: From 0 ft. to 20 ft., From ft. to ft., From ft. to ft.  
 What is the nearest source of possible contamination: 1 Septic tank 4 Lateral lines 7 Pit privy 10 Livestock pens 14 Abandoned water well  
 2 Sewer lines 5 Cess pool 8 Sewage lagoon 11 Fuel storage 15 Oil well/Gas well  
 3 Watertight sewer lines 6 Seepage pit 9 Feedyard 12 Fertilizer storage 16 Other (specify below)  
 13 Insecticide storage No Known Source  
 Direction from well? How many feet?

FROM	TO	LITHOLOGIC LOG	FROM	TO	PLUGGING INTERVALS
0	3	Sandy & topsoil	0	XOX	XXXX
3	22	clay brown sandy	XOX	XX	XXXXXXXXXX
22	45	fine sand & gravel			
45	47	clay tan			
47	50	sand & gravel fine & med			
50	52	clay brown sandy			
52	56	sand & gravel (hard)			
56	57	clay brown			
57	65	sand & gravel fine to med to coarse			
65	99	clay white & brown w/ limestone			
99	119	fine sand, med gravel			
119	123	clay brownish gray			
123	133	sand & gravel fine			
133	170	clay brown streak limestone			

7 CONTRACTOR'S OR LANDOWNER'S CERTIFICATION: This water well was (1) constructed, (2) reconstructed, or (3) plugged under my jurisdiction and was completed on (mo/day/year) 12-2-88 and this record is true to the best of my knowledge and belief. Kansas Water Well Contractor's License No. 185 This Water Well Record was completed on (mo/day/yr) 12-5-88 under the business name of Clarke Well & Equipment Co., Inc. by (signature) *Clarke Well & Equipment Co., Inc.*

OFFICE USE ONLY  
T  
R  
EW  
SEC.  
1/4  
1/4  
1/4