USE TYPEWRITER OR BALL POINT PEN-PRESS FIRMLY, PRINT CLEARLY.

WATER WELL RECORD
KSA 82a-1201-1215

Kansas Department of Health and Environment-Division of Environment
(Water well Contractors)
Topeka, Kansas 66620

1. Location of well:	County	Fraction	Section number	Township number	Range number
	Edwards	1/4 C 1/4 NW 1/4	8	T 25 S	R 16 E W

2. Distance and direction from nearest town or city:
1West 3 South of Belpre East side of rode
Street address of well location if in city:

3. Owner of well: Southwest College
R.R. or street: C/O Albright Investment Co. Inc.
City, state, zip code: 116 East 9th Ave., Windfield, Ks. 67156

4. Locate with "X" in section below: Sketch map:

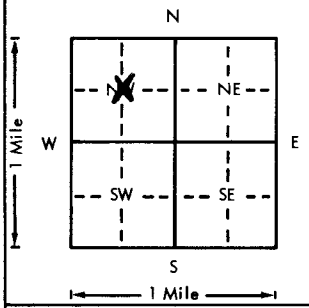

6. Bore hole dia. 29 in. Completion date
Well depth 81 ft. 3-1-77

7. __ Cable tool X Rotary __ Driven __ Dug
__ Hollow rod __ Jetted __ Bored __ Reverse rotary

8. Use: __ Domestic __ Public supply __ Industry
X Irrigation __ Air conditioning __ Stock
__ Lawn __ Oil field water __ Other

9. Casing: Material steel Height: Above or ~~below~~
Threaded ___ Welded X Surface 18 in.
RMP ___ PVC ___ Weight ___ lbs./ft.
Dia. 16 in. to 81 ft. depth Wall Thickness: inches or
Dia. ___ in. to ___ ft. depth gage No. 7 ga.

5. Type and color of material	From	To
Sandy Top Soil	0	2
Clay Brown with Some Gray	2	17
Sand	17	18
Clay	18	28
Sand & Gravel	28	32
Sandy Clay	32	34
Sand & Gravel	34	82
Brown Clay	82	90

(Use a second sheet if needed)

10. Screen: Manufacturer's name Doerrs
Type steel Dia. 16
Slot/~~gauze~~ 3/16 Length 28
Set between 53 ft. and 81 ft.
___ ft. and ___ ft.
Gravel pack? X Size range of material 1/2 3/4 3/8

11. Static water level: mo./day/yr.
15 ft. below land surface Date 1-19-77

12. Pumping level below land surfaces:
16 ft. after 1 hrs. pumping 800 g.p.m.
___ ft. after ___ hrs. pumping ___ g.p.m.
Estimated maximum yield 1000 g.p.m.

13. Water sample submitted: mo./day/yr.
X Yes ___ No Date 1-19-77

14. Well head completion:
___ Pitless adapter ___ Inches above grade

15. Well grouted? yes
With: X Neat cement ___ Bentonite ___ Concrete
Depth: From 0 ft. to 10 ft.

16. Nearest source of possible contamination:
ft. 2m Direction north Type septic
Well disinfected upon completion? ✓ Yes ___ No

17. Pump: ___ Not installed
Manufacturer's name Western Land Roller
Model number 4BH12 HP 100 Volts ___
Length of drop pipe 70 ft. capacity 1000 g.p.m.
Type:
___ Submersible X Turbine
___ Jet ___ Reciprocating
___ Centrifugal ___ Other

18. Elevation:
Topography:
___ Hill
___ Slope
X Upland
___ Valley

19. Remarks:

20. Water well contractor's certification:
This well was drilled under my jurisdiction and this report is true to the best of my knowledge and belief.
Business name Rosencrantz-Bemis 134 License No.
Address Great Bend, Ks. 67530
Signed Fredia Dodson Date 3/22/77
Authorized representative

T 25 R 16 E Sec 8 1/4 1/4 1/4 1/4 Ener

Forward the white, blue and pink copies to the Department of Health and Environment

Form WWC-5

MI-1023