


1 LOCATION OF WATER WELL: Fraction * Section Number Township Number Range Number
 County: Edwards SE 1/4 NW 1/4 SW 1/4 8 T 25 S R 16 EW

Distance and direction from nearest town or city street address of well if located within city? *Near Center of N1/2-SW1/4
 Approx. 3 mi. south and 3/4 west of Belpre

2 WATER WELL OWNER: Southwestern College
 RR#, St. Address, Box #: c/o Schnittker Ag. Service, P.O. Box ~~XXXX~~ 36 Board of Agriculture, Division of Water Resources
 City, State, ZIP Code: Winfield, KS 67156 Application Number: 35001

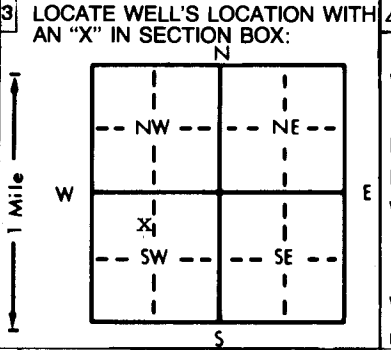

4 DEPTH OF COMPLETED WELL: 114 ft. ELEVATION: unknown
 Depth(s) Groundwater Encountered 1. 26 ft. 2. ft. 3. ft.
 WELL'S STATIC WATER LEVEL: 26 ft. below land surface measured on mo/day/yr 10-31-84
 Pump test data: Well water was not ck'd ft. after hours pumping gpm
 Est. Yield: 1000 gpm; Well water was ft. after hours pumping gpm
 Bore Hole Diameter: 24 in. to 114 ft., and in. to ft.
 WELL WATER TO BE USED AS:
 5 Public water supply 8 Air conditioning 11 Injection well
 1 Domestic 3 Feedlot 6 Oil field water supply 9 Dewatering 12 Other (Specify below)
 2 Irrigation 4 Industrial 7 Lawn and garden only 10 Observation well
 Was a chemical/bacteriological sample submitted to Department? Yes No X; If yes, mo/day/yr sample was submitted
 Water Well Disinfected? Yes No X

5 TYPE OF BLANK CASING USED:
 1 Steel 3 RMP (SR) 5 Wrought iron 8 Concrete tile CASING JOINTS: Glued Clamped
 2 PVC 4 ABS 6 Asbestos-Cement 9 Other (specify below) Welded XX
 7 Fiberglass Threaded
 Blank casing diameter: 16 in. to 74 ft., Dia. in. to ft., Dia. in. to ft.
 Casing height above land surface: 12 in., weight 31.66 lbs./ft. Wall thickness or gauge No. 188
 TYPE OF SCREEN OR PERFORATION MATERIAL:
 1 Steel 3 Stainless steel 5 Fiberglass 8 RMP (SR) 10 Asbestos-cement
 2 Brass 4 Galvanized steel 6 Concrete tile 9 ABS 11 Other (specify)
 12 None used (open hole)
 SCREEN OR PERFORATION OPENINGS ARE:
 1 Continuous slot 3 Mill slot 5 Gauzed wrapped 8 Saw cut 11 None (open hole)
 2 Louvered shutter 4 Key punched 6 Wire wrapped 9 Drilled holes
 7 Torch cut 10 Other (specify) DOERR BRIDGE SLOT
 SCREEN-PERFORATED INTERVALS: From 74 ft. to 114 ft., From ft. to ft.
 GRAVEL PACK INTERVALS: From 10 ft. to 114 ft., From ft. to ft.

6 GROUT MATERIAL: 1 Neat cement 2 Cement grout 3 Bentonite 4 Other
 Grout Intervals: From 0 ft. to 10 ft., From ft. to ft., From ft. to ft.
 What is the nearest source of possible contamination:
 1 Septic tank 4 Lateral lines 7 Pit privy 10 Livestock pens 14 Abandoned water well
 2 Sewer lines 5 Cess pool 8 Sewage lagoon 11 Fuel storage 15 Oil well/Gas well
 3 Watertight sewer lines 6 Seepage pit 9 Feedyard 12 Fertilizer storage 16 Other (specify below) FIELD
 13 Insecticide storage
 Direction from well? all How many feet?

FROM	TO	LITHOLOGIC LOG	FROM	TO	LITHOLOGIC LOG
0	25	Fine sand topsoil & sandy tan clay w/caliche			
25	31	Hard green clay			
31	46	Fine sand & sandy tan clay			
46	55	Very fine sand & gravel			
55	57	Tan clay			
57	77	Sand & gravel, med. some coarse w/a few thin clay streaks			
77	84	Tan sandy clay			
84	113	Sand & gravel, med. to fine, some coarse, clean			
113	114	Yellow & tan Dakota clay			

7 CONTRACTOR'S OR LANDOWNER'S CERTIFICATION: This water well was (1) constructed, (2) reconstructed, or (3) plugged under my jurisdiction and was completed on (mo/day/year) 10-31-84 and this record is true to the best of my knowledge and belief. Kansas Water Well Contractor's License No. 185 This Water Well Record was completed on (mo/day/yr) 1-17-85 under the business name of Clarke Well & Eq., Inc. by (signature)

INSTRUCTIONS: Use typewriter or ball point pen, PLEASE PRESS FIRMLY and PRINT clearly. Please fill in blanks, underline or circle the correct answers. Send top three copies to Kansas Department of Health and Environment, Division of Environment, Environmental Geology Section, Topeka, KS 66620. Send one to WATER WELL OWNER and retain one for your records.

OFFICE USE ONLY T R EW SEC 1/4 1/4 1/4 1/4