


1 LOCATION OF WATER WELL: County: Edwards	Fraction Near the Center $\frac{1}{4}$ $\frac{1}{4}$ SW $\frac{1}{4}$	Section Number 10	Township Number T 25 S	Range Number R 16 E/W
---	--	-----------------------------	----------------------------------	---------------------------------

Distance and direction from nearest town or city street address of well if located within city?
Approximately 4 1/2 miles south and 1 mile east of Belpre, Kansas

2 WATER WELL OWNER: RR#, St. Address, Box # : City, State, ZIP Code :	XXXXXXXXXXXXXXXXXX XXXXXXXXXXXX Belpre, KS 67519-0186	Maloy Breitenbach 2209 Cleveland Great Bend, KS 67530	Board of Agriculture, Division of Water Resources Application Number: 39,916
---	--	---	--

3 LOCATE WELL'S LOCATION WITH AN "X" IN SECTION BOX:

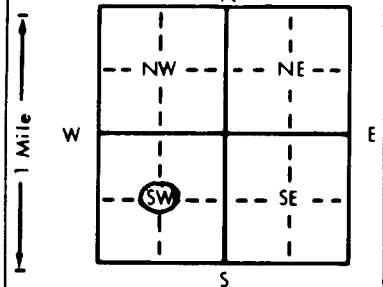

4 DEPTH OF COMPLETED WELL: 208 ft.	ELEVATION: unknown
Depth(s) Groundwater Encountered 1. ft. 2. ft. 3. ft.	
WELL'S STATIC WATER LEVEL 30 ft. below land surface measured on mo/day/yr	
Pump test data: Well water was <u>not ch'd</u> ft. after hours pumping gpm	
Est. Yield unknown gpm: Well water was ft. after hours pumping gpm	
Bore Hole Diameter 24 in. to 208 ft., and in. to ft.	
WELL WATER TO BE USED AS:	
5 Public water supply	8 Air conditioning
1 Domestic	3 Feedlot
2 Irrigation	4 Industrial
6 Oil field water supply	7 Lawn and garden only
9 Dewatering	10 Monitoring well
11 Injection well	12 Other (Specify below)
Was a chemical/bacteriological sample submitted to Department? Yes.....No X; If yes, mo/day/yr sample was submitted	
Water Well Disinfected? Yes No X	

5 TYPE OF BLANK CASING USED:	5 Wrought iron	8 Concrete tile	CASING JOINTS: Glued Clamped
1 Steel	3 RMP (SR)	6 Asbestos-Cement	9 Other (specify below)
2 PVC	4 ABS	7 Fiberglass	Welded X
Blank casing diameter 16 in. to 101 ft., Dia 16 in. to 139 ft., Dia 16 in. to 183 ft.	Threaded.....		
Casing height above land surface 12 in., weight 42.05 lbs./ft. Wall thickness or gauge No. 250			
TYPE OF SCREEN OR PERFORATION MATERIAL:		7 PVC	10 Asbestos-cement
1 Steel	3 Stainless steel	5 Fiberglass	8 RMP (SR)
2 Brass	4 Galvanized steel	6 Concrete tile	9 ABS
11 Other (specify)	12 None used (open hole)		
SCREEN OR PERFORATION OPENINGS ARE:		5 Gauzed wrapped	8 Saw cut
1 Continuous slot	3 Mill slot	6 Wire wrapped	9 Drilled holes
2 Louvered shutter	4 Key punched 101	7 Torch cut 117	10 Other (specify) Bridge Slot
SCREEN-PERFORATED INTERVALS: From 139 ft. to 171 ft., From ft. to ft.		From ft. to ft.	
From 183 ft. to 207 ft., From ft. to ft.		From ft. to ft.	
GRAVEL PACK INTERVALS: From 20 ft. to 208 ft., From ft. to ft.		From ft. to ft.	

6 GROUT MATERIAL:	1 Neat cement	2 <u>Cement grout</u>	3 Bentonite	4 Other
Grout Intervals: From 0 ft. to 20 ft., From ft. to ft., From ft. to ft.				
What is the nearest source of possible contamination:		10 Livestock pens	14 Abandoned water well	
1 Septic tank	4 Lateral lines	7 Pit privy	11 Fuel storage	15 Oil well/Gas well
2 Sewer lines	5 Cess pool	8 Sewage lagoon	12 Fertilizer storage	16 Other (specify below)
3 Watertight sewer lines	6 Seepage pit	9 Feedyard	13 Insecticide storage	None Known
Direction from well?		How many feet?		

FROM	TO	LITHOLOGIC LOG	FROM	TO	PLUGGING INTERVALS
0	10	Topsoil, sand, fine			
10	25	Clay, brown, sandy			
25	50	Clay, brown and white			
50	65	Sand and Gravel, very fine to fine			
65	73	Sand and Gravel, fine, medium, coarse			
73	100	Clay, tan, caliche			
100	118	Sand and Gravel, fine to medium			
118	140	Clay, tan, caliche			
140	158	Sand and Gravel, very fine to fine			
158	159	Clay, brown			
159	172	Sand and Gravel, very fine, fine			
185	208	Sand and Gravel, fine to medium to coarse, sandstone cobble			

7 CONTRACTOR'S OR LANDOWNER'S CERTIFICATION: This water well was (1) constructed, (2) reconstructed, or (3) plugged under my jurisdiction and was completed on (mo/day/year) **6-30-90** and this record is true to the best of my knowledge and belief. Kansas Water Well Contractor's License No. **185** This Water Well Record was completed on (mo/day/yr) **7-5-90** under the business name of **Clarke Well & Equipment, Inc.** by (signature) *Clarke W. Clarke*

OFFICE USE ONLY
T
R
EW
SEC.
1/4
1/4
1/4