


1 LOCATION OF WATER WELL: Fraction  $\frac{1}{4}$  C  $\frac{1}{4}$  NE  $\frac{1}{4}$  Section Number 10 Township Number T 25 S Range Number R 16 EW  
 County: Edwards

Distance and direction from nearest town or city street address of well if located within city?  
 3 3/4 south 1 3/4 East of Belpre, Ks.

2 WATER WELL OWNER: Maloy D. Breitenbach  
 RR#, St. Address, Box #: 2209 Cleveland Board of Agriculture, Division of Water Resources  
 City, State, ZIP Code: Great Bend, Ks. 67530 Application Number: 39,909

3 LOCATE WELL'S LOCATION WITH AN "X" IN SECTION BOX:

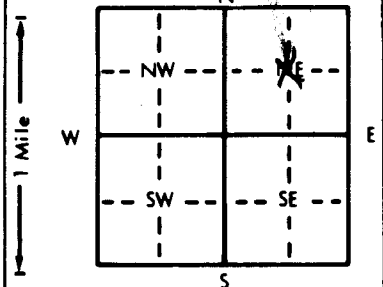

4 DEPTH OF COMPLETED WELL: 177 ft. ELEVATION:  
 Depth(s) Groundwater Encountered 1. ft. 2. ft. 3. ft.  
 WELL'S STATIC WATER LEVEL: 47 ft. below land surface measured on mo/day/yr 8-30-91  
 Pump test data: Well water was ft. after hours pumping gpm  
 Est. Yield: 1500 gpm; Well water was 75 ft. after 2 hours pumping 1500 gpm  
 Bore Hole Diameter: 26 in. to 177 ft., and in. to ft.  
 WELL WATER TO BE USED AS:  
 5 Public water supply 8 Air conditioning 11 Injection well  
 1 Domestic 3 Feedlot 6 Oil field water supply 9 Dewatering 12 Other (Specify below)  
 2 Irrigation 4 Industrial 7 Lawn and garden only 10 Monitoring well  
 Was a chemical/bacteriological sample submitted to Department? Yes No X; If yes, mo/day/yr sample was submitted  
 Water Well Disinfected? Yes hth No

5 TYPE OF BLANK CASING USED:  
 1 Steel 3 RMP (SR) 5 Wrought iron 8 Concrete tile CASING JOINTS: Glued X Clamped  
 2 PVC 4 ABS 6 Asbestos-Cement 9 Other (specify below) Welded  
 7 Fiberglass Threaded

Blank casing diameter: 16 in. to 112 ft., Dia. in. to ft., Dia. in. to ft.  
 Casing height above land surface: 12 in., weight SDR 32.5 lbs./ft. Wall thickness or gauge No.

TYPE OF SCREEN OR PERFORATION MATERIAL:  
 1 Steel 3 Stainless steel 5 Fiberglass 7 PVC 10 Asbestos-cement  
 2 Brass 4 Galvanized steel 6 Concrete tile 8 RMP (SR) 11 Other (specify)  
 9 ABS 12 None used (open hole)

SCREEN OR PERFORATION OPENINGS ARE:  
 1 Continuous slot 3 Mill slot 5 Gauzed wrapped 8 Saw cut 11 None (open hole)  
 2 Louvered shutter 4 Key punched 6 Wire wrapped 9 Drilled holes  
 7 Torch cut 10 Other (specify)

SCREEN-PERFORATED INTERVALS: From 112 ft. to 177 ft., From ft. to ft.  
 GRAVEL PACK INTERVALS: From 20 ft. to 177 ft., From ft. to ft.

6 GROUT MATERIAL: 1 Neat cement 2 Cement grout 3 Bentonite 4 Other  
 Grout Intervals: From 0 ft. to 20 ft., From ft. to ft., From ft. to ft.

What is the nearest source of possible contamination:  
 1 Septic tank 4 Lateral lines 7 Pit privy 10 Livestock pens 14 Abandoned water well  
 2 Sewer lines 5 Cess pool 8 Sewage lagoon 11 Fuel storage 15 Oil well/Gas well  
 3 Watertight sewer lines 6 Seepage pit 9 Feedyard 12 Fertilizer storage 16 Other (specify below)  
 13 Insecticide storage none

Direction from well? How many feet?

FROM	TO	LITHOLOGIC LOG	FROM	TO	PLUGGING INTERVALS
0	4	Top soil	145	172	Sand and gravel with thin clay streaks
4	8	Brown clay	172	178	Sand and gravel with coarse sandstone
8	30	Brown sandy clay			
30	44	Fine sand			
44	48	Brown sandy clay			
48	70	Sand and gravel Medium to fine with clay streaks			
70	76	Brown clay			
76	91	Brown sandy clay			
91	97	Brown clay streaks of sand and gravel			
97	102	Sand and gravel fine to medium			
102	103	Brown clay			
103	131	Fine sand and gravel			
131	135	Gray clay			
135	138	Brown sandy clay streaks of limestone			
138	145	Brown clay streaks of sand and gravel			

7 CONTRACTOR'S OR LANDOWNER'S CERTIFICATION: This water well was (1) constructed, (2) reconstructed, or (3) plugged under my jurisdiction and was completed on (mo/day/year) 9-21-91 and this record is true to the best of my knowledge and belief. Kansas Water Well Contractor's License No. 134 This Water Well Record was completed on (mo/day/yr) Oct. 1-1991 under the business name of Rosencrantz-Bemis by (signature) Fredia Radson