


Edwards

1 LOCATION OF WATER WELL: Fraction NE 1/4 SE 1/4 NW 1/4 Section Number 11 Township Number T 25 S Range Number R 16 EW  
 County: Stafford

Distance and direction from nearest town or city street address of well if located within city?  
2 1/2 E 4 1/2 S Before Kansas

2 WATER WELL OWNER: Doyle Wilson  
 RR#, St. Address, Box #: Macksuille Kansas  
 City, State, ZIP Code: \_\_\_\_\_ Board of Agriculture, Division of Water Resources  
 Application Number: \_\_\_\_\_

3 LOCATE WELL'S LOCATION WITH AN "X" IN SECTION BOX:

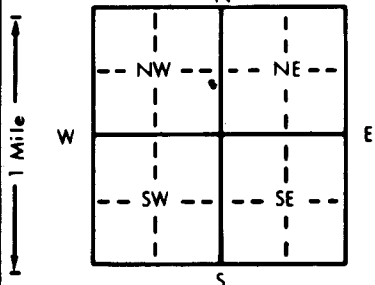

4 DEPTH OF COMPLETED WELL: 82 ft. ELEVATION: \_\_\_\_\_  
 Depth(s) Groundwater Encountered 1. 25 ft. 2. \_\_\_\_\_ ft. 3. \_\_\_\_\_ ft.  
 WELL'S STATIC WATER LEVEL 25 ft. below land surface measured on mo/day/yr 6-9-82  
 Pump test data: Well water was 25 ft. after 1 hours pumping 4 gpm  
 Est. Yield 15 gpm: Well water was \_\_\_\_\_ ft. after \_\_\_\_\_ hours pumping \_\_\_\_\_ gpm  
 Bore Hole Diameter 8 3/4 in. to 82 ft. and \_\_\_\_\_ in. to \_\_\_\_\_ ft.  
 WELL WATER TO BE USED AS:  
 Domestic  Feedlot  6 Oil field water supply  9 Dewatering  12 Other (Specify below)  
 2 Irrigation  4 Industrial  7 Lawn and garden only  10 Observation well  
 Was a chemical/bacteriological sample submitted to Department? Yes \_\_\_\_\_ No ; If yes, mo/day/yr sample was submitted  
 Water Well Disinfected? Yes  No \_\_\_\_\_

5 TYPE OF BLANK CASING USED:  
 1 Steel  3 RMP (SR)  5 Wrought iron  8 Concrete tile CASING JOINTS: Glued  Clamped \_\_\_\_\_  
 2 PVC  4 ABS  6 Asbestos-Cement  9 Other (specify below) Welded \_\_\_\_\_  
 \_\_\_\_\_  7 Fiberglass \_\_\_\_\_ Threaded \_\_\_\_\_  
 Blank casing diameter 5 in. to 62 ft., Dia \_\_\_\_\_ in. to \_\_\_\_\_ ft., Dia \_\_\_\_\_ in. to \_\_\_\_\_ ft.  
 Casing height above land surface 16 in., weight \_\_\_\_\_ lbs./ft. Wall thickness or gauge No. SDR-26

TYPE OF SCREEN OR PERFORATION MATERIAL:  
 1 Steel  3 Stainless steel  5 Fiberglass  8 RMP (SR)  10 Asbestos-cement  
 2 Brass  4 Galvanized steel  6 Concrete tile  9 ABS  12 None used (open hole)

SCREEN OR PERFORATION OPENINGS ARE:  
 1 Continuous slot  3 Mill slot  5 Gauzed wrapped  8 Saw cut  11 None (open hole)  
 2 Louvered shutter  4 Key punched  6 Wire wrapped  9 Drilled holes  
 \_\_\_\_\_  7 Torch cut  10 Other (specify) \_\_\_\_\_

SCREEN-PERFORATED INTERVALS: From 62 ft. to 82 ft., From \_\_\_\_\_ ft. to \_\_\_\_\_ ft., From \_\_\_\_\_ ft. to \_\_\_\_\_ ft.  
 GRAVEL PACK INTERVALS: From 42 ft. to 82 ft., From \_\_\_\_\_ ft. to \_\_\_\_\_ ft., From \_\_\_\_\_ ft. to \_\_\_\_\_ ft.

6 GROUT MATERIAL:  1 Neat cement  2 Cement grout  3 Bentonite  4 Other \_\_\_\_\_  
 Grout Intervals: From 0 ft. to 10 ft., From \_\_\_\_\_ ft. to \_\_\_\_\_ ft., From \_\_\_\_\_ ft. to \_\_\_\_\_ ft.

What is the nearest source of possible contamination:  
 1 Septic tank  4 Lateral lines  7 Pit privy  10 Livestock pens  14 Abandoned water well  
 2 Sewer lines  5 Cess pool  8 Sewage lagoon  11 Fuel storage  15 Oil well/Gas well  
 3 Watertight sewer lines  6 Seepage pit  9 Feedyard  12 Fertilizer storage  16 Other (specify below)  
 \_\_\_\_\_  13 Insecticide storage Passing Cattle

Direction from well? \_\_\_\_\_ How many feet? \_\_\_\_\_

| FROM | TO | LITHOLOGIC LOG                 | FROM | TO | LITHOLOGIC LOG |
|------|----|--------------------------------|------|----|----------------|
| 0    | 1  | Top Soil                       |      |    |                |
| 1    | 8  | Silt & Sand                    |      |    |                |
| 8    | 16 | Brown Clay                     |      |    |                |
| 16   | 24 | White Clay                     |      |    |                |
| 24   | 28 | Tan Clay                       |      |    |                |
| 28   | 47 | White Clay                     |      |    |                |
| 47   | 54 | Sand                           |      |    |                |
| 54   | 63 | GRAY Clay                      |      |    |                |
| 63   | 82 | " " with Sand & GRAVEL STREAKS |      |    |                |

7 CONTRACTOR'S OR LANDOWNER'S CERTIFICATION: This water well was  (1) constructed, (2) reconstructed, or (3) plugged under my jurisdiction and was completed on (mo/day/year) 6-9-82 and this record is true to the best of my knowledge and belief. Kansas Water Well Contractor's License No. 224 This Water Well Record was completed on (mo/day/yr) 8-13-82 under the business name of Carl Hayse Water Well Service by signature Carl Hayse

INSTRUCTIONS: Use typewriter or ball point pen, PLEASE PRESS FIRMLY and PRINT clearly. Please fill in blanks, underline or circle the correct answers. Send top three copies to Kansas Department of Health and Environment, Division of Environment, Environmental Geology Section, Topeka, KS 66620. Send one to WATER WELL OWNER and retain one for your records.

OFFICE USE ONLY  
T 25 S  
R 16  
SEC. 11  
NE 1/4 SE 1/4 NW 1/4