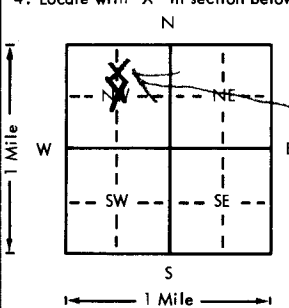


USE TYPEWRITER OR BALL POINT PEN-PRESS FIRMLY, PRINT CLEARLY.

WATER WELL RECORD  
KSA 82a-1201-1215

Kansas Department of Health and Environment-Division of Environment  
(Water well Contractors)  
Topeka, Kansas 66620

OK

1. Location of well: County <u>Edwards</u>		Fraction <u>1/4 C 1/4 NW 1/4</u>		Section number <u>13</u>		Township number T <u>25</u> S R <u>16</u> E <u>0</u>	
2. Distance and direction from nearest town or city: <u>1/2 N 25 E 3 3/4 N from Howardale, Ks</u> Street address of well location if in city:				3. Owner of well: <u>Ran Ashworth</u> R.R. or street: <u>Rt 2</u> City, state, zip code: <u>Larned, Ks 67550</u>			
4. Locate with "X" in section below:  1 Mile				Sketch map: <u>see below</u>		6. Bore hole dia. <u>2 1/2</u> in. Completion date <u>6-23-76</u> Well depth <u>178</u> ft.	
5. Type and color of material				From		To	
<u>top soil</u>				<u>0</u>		<u>3</u>	
<u>Brown clay</u>				<u>3</u>		<u>19</u>	
<u>Brown + gray sandy clay</u>				<u>19</u>		<u>22</u>	
<u>fine sand</u>				<u>22</u>		<u>29</u>	
<u>Brown clay + fine sand</u>				<u>29</u>		<u>43</u>	
<u>sand + white clay</u>				<u>43</u>		<u>47</u>	
<u>sand + gravel</u>				<u>47</u>		<u>73</u>	
<u>Good clean sand + gravel</u>				<u>73</u>		<u>84</u>	
<u>sand + gravel Brown clay</u>				<u>84</u>		<u>100</u>	
<u>Brown, white clay + white rock</u>				<u>100</u>		<u>105</u>	
<u>fine sand clay mixed</u>				<u>105</u>		<u>107</u>	
<u>sand + gravel</u>				<u>107</u>		<u>117</u>	
<u>clay</u>				<u>117</u>		<u>128</u>	
<u>sand</u>				<u>128</u>		<u>138</u>	
<u>sand w/ clay streaks</u>				<u>138</u>		<u>140</u>	
<u>Brown clay white rock</u>				<u>140</u>		<u>149</u>	
18. Elevation: <u>2060</u>		19. Remarks: <u>28633</u> <u>(little more north see above)</u>		20. Water well contractor's certification: This well was drilled under my jurisdiction and this report is true to the best of my knowledge and belief. <u>Rosenberg Benis 134</u> Business name <u>Benis, Ben, Ks.</u> License No. <u>        </u> Address <u>        </u> Signed <u>S. Kilgore</u> Date <u>6-19-76</u> Authorized representative			

Forward the white, blue and pink copies to the Department of Health and Environment

Form WWC-5

2  
2  
1  
6  
13  
1/4  
1/4  
1/4  
C  
NW

USE TYPEWRITER OR BALL POINT PEN-PRESS FIRMLY, PRINT CLEARLY.

WATER WELL RECORD  
KSA 82a-1201-1215

Kansas Department of Health and Environment-Division of Environment  
(Water well Contractors)  
Topeka, Kansas 66620

1. Location of well:	County <b>Edwards</b>	Fraction 1/4 <b>1/4 NW</b> 1/4	Section number <b>13</b>	Township number T <b>25</b> S	Range number R <b>16</b> E/W
2. Distance and direction from nearest town or city: Street address of well location if in city:			3. Owner of well: <b>Ron Ashworth</b> R.R. or street: <b>Rt 2</b> City, state, zip code: <b>Lamed, Ka 67500</b>		
4. Locate with "X" in section below:		Sketch map:		6. Bore hole dia. _____ in. Completion date _____ Well depth _____ ft.	
				7. <input type="checkbox"/> Cable tool <input type="checkbox"/> Rotary <input type="checkbox"/> Driven <input type="checkbox"/> Dug <input type="checkbox"/> Hollow rod <input type="checkbox"/> Jetted <input type="checkbox"/> Bored <input type="checkbox"/> Reverse rotary	
				8. Use: <input type="checkbox"/> Domestic <input type="checkbox"/> Public supply <input type="checkbox"/> Industry <input type="checkbox"/> Irrigation <input type="checkbox"/> Air conditioning <input type="checkbox"/> Stock <input type="checkbox"/> Lawn <input type="checkbox"/> Oil field water <input type="checkbox"/> Other	
5. Type and color of material		From	Ta	9. Casing: Material _____ Height: Above or below Threaded _____ Welded _____ Surface _____ in. RMP _____ PVC _____ Weight _____ lbs./ft. Dia. _____ in. to _____ ft. depth Wall Thickness: inches or Dia. _____ in. to _____ ft. depth gage No. _____	
Sandy clay with Brown + white rock		149	153	10. Screen: Manufacturer's name _____ Type _____ Dia. _____ Slot/gauze _____ Length _____ Set between _____ ft. and _____ ft. _____ ft. and _____ ft. Gravel pack? <input type="checkbox"/> Size range of material _____	
Brown clay		153	155	11. Static water level: _____ mo./day/yr. _____ ft. below land surface Date _____	
Sand + gravel		155	177	12. Pumping level below land surfaces: _____ ft. after _____ hrs. pumping _____ g.p.m. _____ ft. after _____ hrs. pumping _____ g.p.m. Estimated maximum yield _____ g.p.m.	
Yellow Brown + Blue gray clay		177	185	13. Water sample submitted: _____ mo./day/yr. Yes <input type="checkbox"/> No <input type="checkbox"/> Date _____	
				14. Well head completion: <input type="checkbox"/> Pitless adapter _____ Inches above grade	
				15. Well grouted? <input type="checkbox"/> With: <input type="checkbox"/> Neat cement <input type="checkbox"/> Bentonite <input type="checkbox"/> Concrete Depth: From _____ ft. to _____ ft.	
				16. Nearest source of possible contamination: ft. _____ Direction _____ Type _____ Well disinfected upon completion? <input type="checkbox"/> Yes <input type="checkbox"/> No	
				17. Pump: <input type="checkbox"/> Not installed Manufacturer's name _____ Model number _____ HP _____ Volts _____ Length of drop pipe _____ ft. capacity _____ g.p.m. Type: <input type="checkbox"/> Submersible <input type="checkbox"/> Turbine <input type="checkbox"/> Jet <input type="checkbox"/> Reciprocating <input type="checkbox"/> Centrifugal <input type="checkbox"/> Other	
				20. Water well contractor's certification: This well was drilled under my jurisdiction and this report is true to the best of my knowledge and belief. <b>Rosencrantz-Bemis 134</b> Business name _____ License No. _____ Address <b>Great Bend, KS</b> Signed <b>S. K.</b> Date _____ Authorized representative	
18. Elevation:		19. Remarks:			
Topography: <input type="checkbox"/> Hill <input type="checkbox"/> Slope <input type="checkbox"/> Upland <input type="checkbox"/> Valley					

T 25  
 R 16  
 W 13  
 Sec 13  
 1/4  
 1/4  
 1/4  
 1/4  
 NW

Forward the white, blue and pink copies to the Department of Health and Environment

Form WWC-5