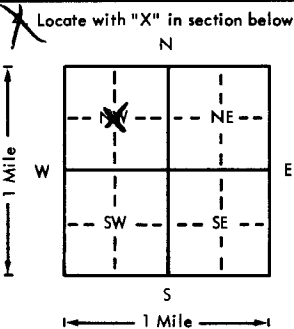


USE TYPEWRITER OR BALL POINT PEN-PRESS FIRMLY, PRINT CLEARLY.

WATER WELL RECORD
KSA 82a-1201-1215

Kansas Department of Health and Environment-Division of Environment
(Water well Contractors)
Topeka, Kansas 66620

1. Location of well: County <u>Edwards</u> Action <u>CNW</u> Section number <u>17</u> Township number <u>T 25 S R 16 E/W</u>																																					
2. Distance and direction from nearest town or city: <u>4.5 3/4 W from Belpre south side of rd</u>																																					
3. Owner of well: <u>Deanna Hal Curtis Johnston</u> R.R. or street: <u>Belpre, Ks.</u> City, state, zip code: <u>Belpre, Ks.</u>																																					
4. Locate with "X" in section below: 																																					
5. Type and color of material																																					
<table border="1"> <thead> <tr> <th></th> <th>From</th> <th>To</th> </tr> </thead> <tbody> <tr> <td><u>Sandy Top Soil</u></td> <td><u>0</u></td> <td><u>2</u></td> </tr> <tr> <td><u>Black Clay</u></td> <td><u>2</u></td> <td><u>6</u></td> </tr> <tr> <td><u>Reddish Clay</u></td> <td><u>6</u></td> <td><u>12</u></td> </tr> <tr> <td><u>Black Clay</u></td> <td><u>12</u></td> <td><u>17</u></td> </tr> <tr> <td><u>White and Red Clay Mixed</u></td> <td><u>17</u></td> <td><u>35</u></td> </tr> <tr> <td><u>Sand & Gravel</u></td> <td><u>35</u></td> <td><u>41</u></td> </tr> <tr> <td><u>White Clay</u></td> <td><u>41</u></td> <td><u>46</u></td> </tr> <tr> <td><u>Sand & Gravel</u></td> <td><u>46</u></td> <td><u>81</u></td> </tr> <tr> <td><u>Brown Clay</u></td> <td><u>81</u></td> <td><u>107</u></td> </tr> <tr> <td><u>Greenish Clay</u></td> <td><u>107</u></td> <td><u>118</u></td> </tr> <tr> <td><u>Shale</u></td> <td><u>118</u></td> <td><u>120</u></td> </tr>
6. Bore hole dia. <u>2 1/2</u> in. Completion date <u>3-16-76</u> Well depth <u>81</u> ft.																																					
7. Cable tool <input checked="" type="checkbox"/> Rotary <input type="checkbox"/> Driven <input type="checkbox"/> Dug <input type="checkbox"/> Hollow rod <input type="checkbox"/> Jetted <input type="checkbox"/> Bored <input type="checkbox"/> Reverse rotary																																					
8. Use: <input type="checkbox"/> Domestic <input type="checkbox"/> Public supply <input type="checkbox"/> Industry <input checked="" type="checkbox"/> Irrigation <input type="checkbox"/> Air conditioning <input type="checkbox"/> Stock <input type="checkbox"/> Lawn <input type="checkbox"/> Oil field water <input type="checkbox"/> Other																																					
9. Casing: Material <u>Steel</u> Height <u>Above</u> or below Threaded <input type="checkbox"/> Welded <input checked="" type="checkbox"/> Surface <input type="checkbox"/> in. RMP <input type="checkbox"/> PVC <input type="checkbox"/> Weight <input type="checkbox"/> lbs./ft. Dia. <u>1 1/2</u> in. to <u>81</u> ft. depth Wall Thickness: inches or Dia. <input type="checkbox"/> in. to <input type="checkbox"/> ft. depth Gage No. <u>7</u>																																					
10. Screen: Manufacturer's name <u>Diems</u> Type <u>steel</u> Dia. <u>1 1/2</u> Slot/gauge <u>3/16</u> Length <u>28</u> Set between <u>53</u> ft. and <u>81</u> ft. <input type="checkbox"/> ft. and <input type="checkbox"/> ft. Gravel pack? <input checked="" type="checkbox"/> Size range of material <u>1/2 3/4 3/8</u>																																					
11. Static water level: <u>15</u> ft. below land surface Date <u>12-12-75</u> mo./day/yr.																																					
12. Pumping level below land surfaces: <u>13</u> ft. after <u>1</u> hrs. pumping <u>1000</u> g.p.m. <input type="checkbox"/> ft. after <input type="checkbox"/> hrs. pumping <input type="checkbox"/> g.p.m. Estimated maximum yield <u>1200</u> g.p.m.																																					
13. Water sample submitted: <input checked="" type="checkbox"/> Yes <input type="checkbox"/> No Date <input type="checkbox"/> mo./day/yr.																																					
14. Well head completion: <input type="checkbox"/> Pitless adapter <input type="checkbox"/> Inches above grade																																					
15. Well grouted? <input checked="" type="checkbox"/> With: <input type="checkbox"/> Neat cement <input type="checkbox"/> Bentonite <input checked="" type="checkbox"/> Concrete Depth: From <u>0</u> ft. to <u>10</u> ft.																																					
16. Nearest source of possible contamination: ft. <u>3/4</u> Direction <u>W</u> Type <u>Corral</u> Well disinfected upon completion? <input type="checkbox"/> Yes <input type="checkbox"/> No																																					
17. Pump: <input type="checkbox"/> Not installed Manufacturer's name <u>WLR</u> Model number <u>5-DHC-12</u> HP <u>50</u> Volts <input type="checkbox"/> Length of drop pipe <u>70</u> ft. capacity <u>1000</u> g.p.m. Type: <input type="checkbox"/> Submersible <input checked="" type="checkbox"/> Turbine <input type="checkbox"/> Jet <input type="checkbox"/> Reciprocating <input type="checkbox"/> Centrifugal <input type="checkbox"/> Other																																					
(Use a second sheet if needed)																																					
18. Elevation: <u>2089</u> Topography: <input type="checkbox"/> Hill <input type="checkbox"/> Slope <input checked="" type="checkbox"/> Upland <input type="checkbox"/> Valley	19. Remarks: <u>29372</u> <u>25 16 17 NBX</u>																																				
20. Water well contractor's certification: This well was drilled under my jurisdiction and this report is true to the best of my knowledge and belief. <u>Rosemary & Bernice 134</u> Business name <u>Great Bend, Ks.</u> License No. <input type="checkbox"/> Address <u>Great Bend, Ks.</u> Signed <u>Freda Dodson</u> Date <u>9/29/76</u> Authorized representative																																					

T 25 S R 16 E S 17 CWB
 Sec. 17

Forward the white, blue and pink copies to the Department of Health and Environment

Form WWC-5