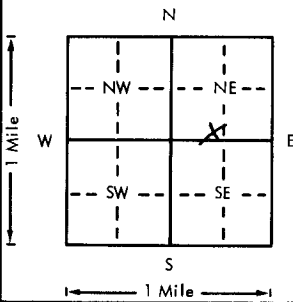


USE TYPEWRITER OR BALL POINT PEN-PRESS FIRMLY, PRINT CLEARLY.

WATER WELL RECORD  
KSA 82a-1201-1215

Kansas Department of Health and Environment-Division of Environment  
(Water well Contractors)  
Topeka, Kansas 66620

1. Location of well: County <u>Edwards</u> Fraction <u>SE 1/4 SW 1/4 NE 1/4</u> Section number <u>24</u> Township number <u>T 25 S</u> Range number <u>R 16 E/W</u>	
2. Distance and direction from nearest town or city: <u>Bulace 6 south</u> Street address of well location if in city: <u>Highway north side</u>	
3. Owner of well: <u>B. V. Delo.</u> R.R. or street: <u>1012 Walnut.</u> City, state, zip code: <u>Great Bend Kansas 67530</u>	
4. Locate with "X" in section below: Sketch map: 	
5. Type and color of material	
	From To
	<u>Five Sand</u> 0 10
	<u>Sandy Clay</u> 10 25
	<u>Clay</u> 25 40
	<u>Gravel</u> 40 60
6. Bore hole dia. <u>9</u> in. Completion date <u>2-9-79</u> Well depth <u>60</u> ft.	
7. Cable tool <input type="checkbox"/> Rotary <input checked="" type="checkbox"/> Driven <input type="checkbox"/> Dug <input type="checkbox"/> Hollow rod <input type="checkbox"/> Jetted <input type="checkbox"/> Bored <input type="checkbox"/> Reverse rotary <input type="checkbox"/>	
8. Use: Domestic <input type="checkbox"/> Public supply <input type="checkbox"/> Industry <input type="checkbox"/> Irrigation <input type="checkbox"/> Air conditioning <input type="checkbox"/> Stock <input type="checkbox"/> Lawn <input checked="" type="checkbox"/> Oil field water <input type="checkbox"/> Other <input type="checkbox"/>	
9. Casing: Material <input type="checkbox"/> Height: Above or below Threaded <input type="checkbox"/> Welded <input checked="" type="checkbox"/> Surface <u>12</u> in. RMP <input type="checkbox"/> PVC <input checked="" type="checkbox"/> Weight <u>278.3</u> lbs./ft. Dia. <u>5</u> in. to <u>60</u> ft. depth Wall Thickness: inches or Dia. <input type="checkbox"/> in. to <input type="checkbox"/> ft. depth gage No. <u>265</u>	
10. Screen: Manufacturer's name <u>Caseless</u> Type <u>Saw</u> Dia. <u>5</u> Slot/gauze <u>18</u> Length <u>20</u> Set between <u>60</u> ft. and <u>40</u> ft. <input type="checkbox"/> ft. and <input type="checkbox"/> ft. Gravel pack <u>yes</u> Size range of material <u>1/4-1/8</u>	
11. Static water level: <u>17</u> ft. below land surface Date <u>2-9-79</u> mo./day/yr.	
12. Pumping level below land surfaces: ____ ft. after ____ hrs. pumping ____ g.p.m. ____ ft. after ____ hrs. pumping ____ g.p.m. Estimated maximum yield ____ g.p.m.	
13. Water sample submitted: ____ mo./day/yr. ____ Yes <input checked="" type="checkbox"/> No Date ____	
14. Well head completion: ____ Pitless adapter <u>12</u> Inches above grade	
15. Well grouted? <u>yes</u> With: ____ Neat cement <input checked="" type="checkbox"/> Bentonite ____ Concrete Depth: From ____ 0 ft. to <u>10</u> ft.	
16. Nearest source of possible contamination: ____ ft. ____ Direction ____ Type <u>None</u> Well disinfected upon completion? ____ Yes <input checked="" type="checkbox"/> No	
17. Pump: <input checked="" type="checkbox"/> Not installed Manufacturer's name ____ Model number ____ HP ____ Volts ____ Length of drop pipe ____ ft. capacity ____ g.p.m. Type: ____ Submersible ____ Turbine ____ Jet ____ Reciprocating ____ Centrifugal ____ Other	
(Use a second sheet if needed)	
18. Elevation:  Topography: ____ Hill <input checked="" type="checkbox"/> Slope ____ Upland ____ Valley	19. Remarks:
20. Water well contractor's certification: This well was drilled under my jurisdiction and this report is true to the best of my knowledge and belief. <u>Muges Water Well</u> <u>143</u> Business name License No. Address <u>Great Bend KS</u> Signed <u>Clyde Kasendahl</u> Date <u>2-9-79</u> Authorized representative	

T 25  
R 16  
Sec 24  
1/4 1/4 1/4  
S.E.S.W.N.E

Forward the white, blue and pink copies to the Department of Health and Environment

Form WWC-5