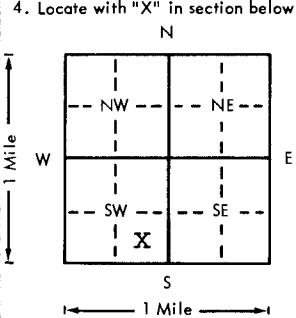


USE TYPEWRITER OR BALL POINT PEN-PRESS FIRMLY, PRINT CLEARLY.

WATER WELL RECORD
KSA 820-1201-1215

Kansas Department of Health and Environment-Division of Environment
(Water well Contractors)
Topeka, Kansas 66620

1. Location of well:	County Edwards	Fraction 1/4 CS04 NW1/4	Section number 35	Township number T 25 S R 16W E/W	Range number
2. Distance and direction from nearest town or city: Street address of well location if in city: 1 1/2 ne Trousdale, Ks.			3. Owner of well: Gabbert-Jones Ind. R.R. or street: 830 Sutton Pl. City, state, zip code: Wichita, Ks. 67202		
4. Locate with "X" in section below: 			Sketch map:		
5. Type and color of material			From	To	6. Bore hole dia. 8 in. Completion date _____ Well depth 62 ft. 2-2-78
Top Soil-Clay			0	17	7. <input checked="" type="checkbox"/> Cable tool <input checked="" type="checkbox"/> Rotary <input type="checkbox"/> Driven <input type="checkbox"/> Dug <input type="checkbox"/> Hollow rod <input type="checkbox"/> Jetted <input type="checkbox"/> Bored <input type="checkbox"/> Reverse rotary
Sand			17	29	8. Use: <input type="checkbox"/> Domestic <input type="checkbox"/> Public supply <input type="checkbox"/> Industry <input type="checkbox"/> Irrigation <input type="checkbox"/> Air conditioning <input type="checkbox"/> Stock <input type="checkbox"/> Lawn <input checked="" type="checkbox"/> Oil field water <input type="checkbox"/> Other
Clay			29	38	9. Casing: Material _____ Height: Above SDMEX _____ Threaded _____ Welded _____ Surface 12 in. RMP _____ PVC <input checked="" type="checkbox"/> Weight 2.8 lbs./ft. Dia. 5 in. to 62 ft. depth Wall Thickness _____ inches Dia. _____ in. to _____ ft. depth gage No. sch 40
Sand-Gravel			38	62	10. Screen: Manufacturer's name Jetstream Type pvc Dia. 5" Slot/gauze 1/32" Length 20' Set between 42 ft. and 62 ft. _____ ft. and _____ ft. Gravel pack? <input checked="" type="checkbox"/> Size range of material 1/8-3/4"
					11. Static water level: _____ mo./day/yr. 12 ft. below land surface Date 2-2-78
					12. Pumping level below land surfaces: _____ ft. after _____ hrs. pumping _____ g.p.m. _____ ft. after _____ hrs. pumping _____ g.p.m. Estimated maximum yield 100 g.p.m.
					13. Water sample submitted: _____ mo./day/yr. <input type="checkbox"/> Yes <input checked="" type="checkbox"/> No Date _____
					14. Well head completion: <input type="checkbox"/> Pitless adapter 12 Inches above grade
					15. Well grouted? <input checked="" type="checkbox"/> With: <input type="checkbox"/> Neat cement <input checked="" type="checkbox"/> Bentonite <input type="checkbox"/> Concrete Depth: From 0 ft. to 10 ft.
					16. Nearest source of possible contamination: oil ft. 55 Direction s Type test Well disinfected upon completion? <input type="checkbox"/> Yes <input checked="" type="checkbox"/> No
					17. Pump: <input checked="" type="checkbox"/> Not installed Manufacturer's name _____ Model number _____ HP _____ Volts _____ Length of drop pipe _____ ft. capacity _____ g.p.m. Type: <input type="checkbox"/> Submersible <input type="checkbox"/> Turbine <input type="checkbox"/> Jet <input type="checkbox"/> Reciprocating <input type="checkbox"/> Centrifugal <input type="checkbox"/> Other
			(Use a second sheet if needed)		
18. Elevation:	19. Remarks:		20. Water well contractor's certification: This well was drilled under my jurisdiction and this report is true to the best of my knowledge and belief. Kellys Waterwell Ser 186 Business name License No. _____ Address R2 Great Bend, Ks. Signed Kelly Price Date 8-30-78 Authorized representative		
Topography: <input type="checkbox"/> Hill <input type="checkbox"/> Slope <input checked="" type="checkbox"/> Upland <input type="checkbox"/> Valley					

T 25 S R 16W E/W
 Sec 35
 1/4 1/4 1/4 1/4
 CSE NW

Forward the white, blue and pink copies to the Department of Health and Environment

Form WWC-5