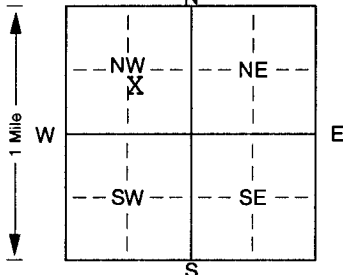


1 LOCATION OF WATER WELL: County: <b>Edwards</b>	Fraction <b>NW 1/4 SE 1/4 NW 1/4</b>	Section Number <b>4</b>	Township Number <b>T 25 S</b>	Range Number <b>R 16w E/W</b>
---	---	----------------------------	----------------------------------	----------------------------------

Distance and direction from nearest town or city street address of well if located within city?  
**2 1/2 S of Belpre, Ks.**

2 WATER WELL OWNER: **Paul Skalsky Sterling Drilling Co. Wilson B-5**  
 RR#, St. Address, Box #: **P. O. Box 1006**  
 City, State, ZIP Code: **Belpre, Ks. 67519 Pratt, Ks. 67124**  
 Board of Agriculture, Division of Water Resources  
 Application Number: **20000180**

3 LOCATE WELL'S LOCATION WITH AN "X" IN SECTION BOX: 	4 DEPTH OF COMPLETED WELL: <b>86</b> ft. ELEVATION: <b>unknown</b> Depth(s) Groundwater Encountered 1. <b>20</b> ft. 2. _____ ft. 3. _____ ft. WELL'S STATIC WATER LEVEL <b>20</b> ft. below land surface measured on mo/day/yr <b>10/8/01</b> Pump test data: Well water was _____ ft. after _____ hours pumping _____ gpm Est. Yield _____ gpm: Well water was _____ ft. after _____ hours pumping _____ gpm Bore Hole Diameter <b>8</b> in. to <b>86</b> ft., and _____ in. to _____ ft. WELL WATER USED AS: 1 Domestic <b>3 Feedlot</b> <b>6 Oil field water supply</b> 9 Dewatering 12 Other (Specify below) 2 Irrigation 4 Industrial 7 Domestic (lawn & garden) 10 Monitoring well _____ Was a chemical/bacteriological sample submitted to Department? Yes. _____ No. _____; If yes, mo/day/yrs sample was submitted Water Well Disinfected? Yes _____ No _____
--	---

5 TYPE OF BLANK CASING USED:  
 1 Steel 3 RMP (SR) 5 Wrought iron 8 Concrete tile CASING JOINTS: Glued. \_\_\_\_\_ Clamped. \_\_\_\_\_  
 2 PVC 4 ABS 6 Asbestos-Cement 9 Other (specify below) Welded \_\_\_\_\_  
 7 Fiberglass \_\_\_\_\_ Threaded. \_\_\_\_\_  
 Blank casing diameter **5** in. to **66** ft., Dia \_\_\_\_\_ in. to \_\_\_\_\_ ft., Dia \_\_\_\_\_ in. to \_\_\_\_\_ ft.  
 Casing height above land surface **3 ft. below** \_\_\_\_\_ in., weight \_\_\_\_\_ lbs./ft. Wall thickness or gauge No. \_\_\_\_\_  
 TYPE OF SCREEN OR PERFORATION MATERIAL:  
 1 Steel 3 Stainless steel 5 Fiberglass 7 PVC 10 Asbestos-cement  
 2 Brass 4 Galvanized steel 6 Concrete tile 8 RMP (SR) 11 Other (specify) \_\_\_\_\_  
 9 ABS 12 None used (open hole)  
 SCREEN OR PERFORATION OPENINGS ARE:  
 1 Continuous slot 5 Gauzed wrapped 8 Saw cut 11 None (open hole)  
 2 Louvered shutter 3 Mill slot 6 Wire wrapped 9 Drilled holes  
 4 Key punched 7 Torch cut 10 Other (specify) \_\_\_\_\_ ft.  
 SCREEN-PERFORATED INTERVALS: From **66** ft. to **86** ft., From \_\_\_\_\_ ft. to \_\_\_\_\_ ft.  
 From \_\_\_\_\_ ft. to \_\_\_\_\_ ft., From \_\_\_\_\_ ft. to \_\_\_\_\_ ft.  
 GRAVEL PACK INTERVALS: From **21** ft. to **86** ft., From \_\_\_\_\_ ft. to \_\_\_\_\_ ft.  
 From \_\_\_\_\_ ft. to \_\_\_\_\_ ft., From \_\_\_\_\_ ft. to \_\_\_\_\_ ft.

6 GROUT MATERIAL: 1 Neat cement 2 Cement grout 3 Bentonite 4 Other \_\_\_\_\_  
 Grout Intervals: From **20** ft. to **3** ft., From \_\_\_\_\_ ft. to \_\_\_\_\_ ft., From \_\_\_\_\_ ft. to \_\_\_\_\_ ft.  
 What is the nearest source of possible contamination:  
 1 Septic tank 4 Lateral lines 7 Pit privy 10 Livestock pens 14 Abandoned water well  
 2 Sewer lines 5 Cess pool 8 Sewage lagoon 11 Fuel storage 15 Oil well/Gas well  
 3 Watertight sewer lines 6 Seepage pit 9 Feedyard 12 Fertilizer storage 16 Other (specify below)  
 13 Insecticide storage \_\_\_\_\_  
 Direction from well? \_\_\_\_\_ How many feet? \_\_\_\_\_

FROM	TO	LITHOLOGIC LOG	FROM	TO	PLUGGING INTERVALS
			86	20	sand and gravel
			20	3	bentonite
			3	0	top soil

7 CONTRACTOR'S OR LANDOWNER'S CERTIFICATION: This water well was (1) constructed, (2) reconstructed, or (3) plugged under my jurisdiction and was completed on (mo/day/year) **10/08/01** and this record is true to the best of my knowledge and belief. Kansas Water Well Contractor's Licence No. **186**. This Water Well Record was completed on (mo/day/yr) **10/10/01** under the business name of **Kelly's Water Well Service, Inc.** by (signature) *Kathryn L. Brad*