

CORRECTION TO WATER WELL RECORD (WWC-5)

The following correction(s) was made to the attached WWC-5 log in order to rectify lacking or incorrect information.

Fraction (1/4 1/4 1/4) Section-Township-Range changed:

listed as NW NE SW, 4-255-10W

changed to NW NE SW, 4-255-16W

Other changes: Initial statements: _____

Changed to: _____

Comments: _____

verification method: Location of Wilson B-3 gas well, written description,
and Belpre 1:24,000 topo. map.

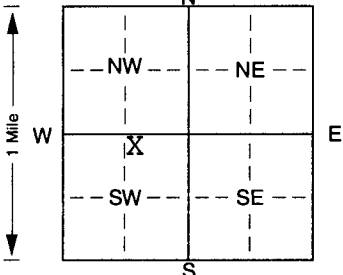
initials: DR date: 11/26/2002

submitted by: Kansas Geological Survey, Data Resources Library, 1930 Constant Ave., Lawrence, KS 66047-3726
to: Kansas Dept of Health & Environment Bureau of Water Industrial Programs, Bldg 283, Forbes Field, KS 66620

1 LOCATION OF WATER WELL: County: <u>Edwards</u>	Fraction <u>NW</u> ¼ <u>NE</u> ¼ <u>SW</u> ¼	Section Number <u>4</u>	Township Number T <u>25</u> S	Range Number R <u>10w</u> EW
---	---	----------------------------	----------------------------------	---------------------------------

Distance and direction from nearest town or city street address of well if located within city?
2 1/4S of Belpre, Ks.

2 WATER WELL OWNER: <u>Mary I. Bran</u>	<u>Sterling Dilling Co.</u>	<u>Wilson B-3</u>
RR#, St. Address, Box # : City, State, ZIP Code : <u>Belpre, Ks. 67519</u>	<u>P. O. Box 1006</u> <u>Pratt, Ks. 67124</u>	Board of Agriculture, Division of Water Resources Application Number: <u>990180</u>

3 LOCATE WELL'S LOCATION WITH AN "X" IN SECTION BOX: 	4 DEPTH OF COMPLETED WELL: <u>79</u> ft. ELEVATION: <u>unknown</u>
	Depth(s) Groundwater Encountered 1. <u>17</u> ft. 2. _____ ft. 3. _____ ft. WELL'S STATIC WATER LEVEL <u>17</u> ft. below land surface measured on mo/day/yr <u>10/08/01</u> Pump test data: Well water was _____ ft. after _____ hours pumping _____ gpm Est. Yield _____ gpm: Well water was _____ ft. after _____ hours pumping _____ gpm Bore Hole Diameter: <u>8</u> in. to <u>79</u> ft., and _____ in. to _____ ft. WELL WATER TO BE USED AS: 1 Domestic <u>was</u> 3 Feedlot 6 Oil field water supply 9 Dewatering 12 Other (Specify below) 2 Irrigation 4 Industrial 7 Domestic (lawn & garden) 10 Monitoring well _____ Was a chemical/bacteriological sample submitted to Department? Yes. _____ No. _____; If yes, mo/day/yr sample was submitted _____ Water Well Disinfected? Yes _____ No _____

5 TYPE OF BLANK CASING USED:	5 Wrought iron	8 Concrete tile	CASING JOINTS: Glued. _____ Clamped. _____
1 Steel	3 RMP (SR)	6 Asbestos-Cement	9 Other (specify below) _____
2 <u>PVC</u>	4 ABS	7 Fiberglass	_____ Welded _____
Blank casing diameter: <u>5</u> in. to <u>59</u> ft., Dia _____ in. to _____ ft., Dia _____ in. to _____ ft.			_____ Threaded _____
Casing height above land surface: <u>3 ft below</u> in., weight _____ lbs./ft. Wall thickness or gauge No. _____			
TYPE OF SCREEN OR PERFORATION MATERIAL:	<u>7 PVC</u>	10 Asbestos-cement	
1 Steel	3 Stainless steel	5 Fiberglass	8 RMP (SR)
2 Brass	4 Galvanized steel	6 Concrete tile	9 ABS
SCREEN OR PERFORATION OPENINGS ARE:	5 Gauzed wrapped	8 Saw cut	11 None (open hole)
1 Continuous slot	3 Mill slot	6 Wire wrapped	9 Drilled holes
2 Louvered shutter	4 Key punched	7 Torch cut	10 Other (specify) _____ ft.
SCREEN-PERFORATED INTERVALS: From <u>59</u> ft. to <u>79</u> ft., From _____ ft. to _____ ft.			
GRAVEL PACK INTERVALS: From <u>30</u> ft. to <u>79</u> ft., From _____ ft. to _____ ft.			

6 GROUT MATERIAL:	1 Neat cement	2 Cement grout	<u>3 Bentonite</u>	4 Other _____
Grout Intervals: From <u>17</u> ft. to <u>3</u> ft., From _____ ft. to _____ ft., From _____ ft. to _____ ft.				
What is the nearest source of possible contamination:	10 Livestock pens	14 Abandoned water well		
1 Septic tank	4 Lateral lines	7 Pit privy	11 Fuel storage	15 Oil well/Gas well
2 Sewer lines	5 Cess pool	8 Sewage lagoon	12 Fertilizer storage	16 Other (specify below)
3 Watertight sewer lines	6 Seepage pit	9 Feedyard	13 Insecticide storage	
Direction from well?			How many feet?	

FROM	TO	LITHOLOGIC LOG	FROM	TO	PLUGGING INTERVALS
			<u>79</u>	<u>17</u>	<u>sand and gravel</u>
			<u>17</u>	<u>3</u>	<u>bentonite</u>
			<u>3</u>	<u>0</u>	<u>top soil</u>

7 CONTRACTOR'S OR LANDOWNER'S CERTIFICATION: This water well was (1) constructed, (2) reconstructed, or (3) plugged under my jurisdiction and was completed on (mo/day/year) 10/08/01 and this record is true to the best of my knowledge and belief. Kansas Water Well Contractor's Licence No. 186. This Water Well Record was completed on (mo/day/yr) 10/10/01 under the business name of Kelly's Water Well Service, Inc. by (signature) Kathryn L. Good