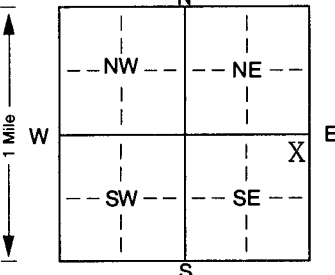


1 LOCATION OF WATER WELL: Fraction NE 1/4 NE 1/4 SE 1/4 Section Number 5 Township Number T 25 S Range Number R 16 ~~EW~~
 County: Edwards

Distance and direction from nearest town or city street address of well if located within city?
 2 3/4 south of Belpre, KS

2 WATER WELL OWNER: Castelli Exploration, Inc.
 RR#, St. Address, Box # : 9500 Westgate Drive - Suite 101 Board of Agriculture, Division of Water Resources
 City, State, ZIP Code : Oklahoma City, OK 73162 Application Number: 20029059

3 LOCATE WELL'S LOCATION WITH AN "X" IN SECTION BOX:

 4 DEPTH OF COMPLETED WELL: 85 ft. ELEVATION:
 Depth(s) Groundwater Encountered 1 ft. 2 ft. 3 ft.
 WELL'S STATIC WATER LEVEL 27 ft. below land surface measured on mo/day/yr 4-17-02
 Pump test data: Well water was ... ft. after ... hours pumping ... gpm
 Est. Yield NA gpm: Well water was ... ft. after ... hours pumping ... gpm
 Bore Hole Diameter 9 in. to 85 ft., and ... in. to ... ft.
 WELL WATER TO BE USED AS:
 1 Domestic 3 Feedlot 6 Oil field water supply 9 Dewatering 12 Other (Specify below)
 2 Irrigation 4 Industrial 7 Domestic (lawn & garden) 10 Monitoring well
 Was a chemical/bacteriological sample submitted to Department? Yes ... No X ... ; If yes, mo/day/yr sample was submitted
 Water Well Disinfected? Yes ... No X

5 TYPE OF BLANK CASING USED:
 1 Steel 3 RMP (SR) 5 Wrought iron 8 Concrete tile CASING JOINTS: Glued X Clamped ...
 2 PVC 4 ABS 6 Asbestos-Cement 9 Other (specify below) Welded ...
 7 Fiberglass Threaded ...
 Blank casing diameter 5 in. to 65 ft., Dia ... in. to ... ft., Dia ... in. to ... ft.
 Casing height above land surface 24 in., weight SDR-26 lbs./ft. Wall thickness or gauge No. ...
 TYPE OF SCREEN OR PERFORATION MATERIAL:
 1 Steel 3 Stainless steel 5 Fiberglass 7 PVC 10 Asbestos-cement
 2 Brass 4 Galvanized steel 6 Concrete tile 8 RMP (SR) 11 Other (specify) ...
 9 ABS 12 None used (open hole)
 SCREEN OR PERFORATION OPENINGS ARE:
 1 Continuous slot 3 Mill slot 5 Gauzed wrapped 8 Saw cut 11 None (open hole)
 2 Louvered shutter 4 Key punched 6 Wire wrapped 9 Drilled holes
 7 Torch cut 10 Other (specify) ... ft.
 SCREEN-PERFORATED INTERVALS: From 85 ft. to 65 ft., From ... ft. to ... ft.
 GRAVEL PACK INTERVALS: From 85 ft. to 20 ft., From ... ft. to ... ft.

6 GROUT MATERIAL: 1 Neat cement 2 Cement grout 3 Bentonite 4 Other hole plug
 Grout Intervals: From 20 ft. to 0 ft., From ... ft. to ... ft., From ... ft. to ... ft.
 What is the nearest source of possible contamination:
 1 Septic tank 4 Lateral lines 7 Pit privy 10 Livestock pens 14 Abandoned water well
 2 Sewer lines 5 Cess pool 8 Sewage lagoon 11 Fuel storage 15 Oil well/Gas well
 3 Watertight sewer lines 6 Seepage pit 9 Feedyard 12 Fertilizer storage 16 Other (specify below)
 13 Insecticide storage None
 Direction from well? How many feet?

FROM	TO	LITHOLOGIC LOG	FROM	TO	PLUGGING INTERVALS
0	2	sandy top soil			
2	5	gray clay			
5	11	sandy brown clay			
11	26	tan and gray clay			
26	31	sandy gray clay			
31	43	small gravel and clay mix			
43	85	sand and gravel, clean, medium, loose			

7 CONTRACTOR'S OR LANDOWNER'S CERTIFICATION: This water well was (1) constructed, (2) reconstructed, or (3) plugged under my jurisdiction and was completed on (mo/day/year) 4-17-02 and this record is true to the best of my knowledge and belief. Kansas Water Well Contractor's Licence No. 134 This Water Well Record was completed on (mo/day/yr) 4-29-02 under the business name of Rosencrantz-Bemis by (signature) Fredia Adson