


1 LOCATION OF WATER WELL: Fraction SE 1/4 SE 1/4 SE 1/4 Section Number 31 Township Number T 25 S Range Number R 16 E
 County: Edwards

Distance and direction from nearest town or city street address of well if located within city?
2 1/2 W of Traskley 1/4 North - West Side of Road

2 WATER WELL OWNER: Steve Mayhew
 RR#, St. Address, Box #: Rt 1, Box 67 Lewis, KS 67552
 City, State, ZIP Code: Lewis, KS 67552
 Board of Agriculture, Division of Water Resources
 Application Number: Ed 2004

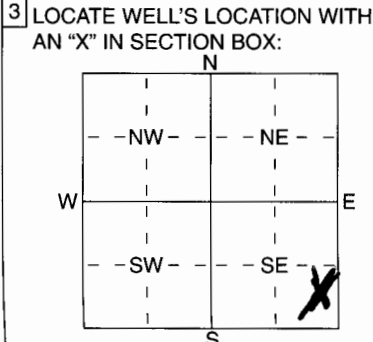

4 DEPTH OF COMPLETED WELL 61 ft. ELEVATION: 9-25-05
 Depth(s) Groundwater Encountered 1 ft. 2 ft. 3 ft.
 WELL'S STATIC WATER LEVEL 40 ft. below land surface measured on mo/day/yr 9-25-05
 Pump test data: Well water was ft. after hours pumping gpm
 Est. Yield 55 gpm: Well water was ft. after hours pumping gpm
 WELL WATER TO BE USED AS:
 Domestic 3 Feedlot 6 Oil field water supply 9 Dewatering 12 Other (Specify below)
 2 Irrigation 4 Industrial 7 Domestic (lawn & garden) 10 Monitoring well
 Was a chemical/bacteriological sample submitted to Department? Yes No ; If yes, mo/day/yr sample was submitted
 Water Well Disinfected? Yes No

5 TYPE OF BLANK CASING USED:
 1 Steel 3 RMP (SR) 5 Wrought iron 8 Concrete tile CASING JOINTS: Glued Clamped
 2 PVC 4 ABS 6 Asbestos-Cement 9 Other (specify below) Welded
 Blank casing diameter 5 to 61 ft., Dia 160 in. to ft., Dia in. to ft.
 Casing height above land surface 12 in., weight 160 lbs./ft. Wall thickness or gauge No.
 TYPE OF SCREEN OR PERFORATION MATERIAL:
 1 Steel 3 Stainless Steel 5 Fiberglass 8 RMP (SR) 10 Asbestos-Cement
 2 Brass 4 Galvanized Steel 6 Concrete tile 9 ABS 11 Other (Specify)
 12 None used (open hole)
 SCREEN OR PERFORATION OPENINGS ARE:
 1 Continuous slot 3 Mill slot 5 Gauzed wrapped 8 Saw cut 11 None (open hole)
 2 Louvered shutter 4 Key punched 6 Wire wrapped 9 Drilled holes
 7 Torch cut 10 Other (specify) ft.
 SCREEN-PERFORATED INTERVALS: From 61 ft. to 20 ft., From ft. to ft.
 GRAVEL PACK INTERVALS: From 61 ft. to 22 ft., From ~~22~~ ft. to ~~0~~ ft.

6 GROUT MATERIAL: 1 Neat cement Cement grout 3 Bentonite 4 Other
 Grout Intervals: From 22 ft. to 0 ft., From ft. to ft., From ft. to ft.
 What is the nearest source of possible contamination:
 1 Septic tank 4 Lateral lines 7 Pit privy 11 Fuel storage 14 Abandoned water well
 2 Sewer lines 5 Cess pool 8 Sewage lagoon 12 Fertilizer storage 15 Oil well/Gas well
 3 Watertight sewer lines 6 Seepage pit 9 Feedyard 13 Insecticide storage 16 Other (specify below)
 Direction from well? SE How many feet? 100ft

FROM	TO	LITHOLOGIC LOG	FROM	TO	PLUGGING INTERVALS
0	6	Sandy top soil			
6	18	Tan Clay			
18	20	Coarse Sand			
20	35	Tan Clay			
35	41	Fine Sand			
41	55	Coarse Sand			
55	61	Fine Sand			

7 CONTRACTOR'S OR LANDOWNER'S CERTIFICATION: This water well was constructed, (2) reconstructed, or (3) plugged under my jurisdiction and was completed on (mo/day/year) 9-25-05 and this record is true to the best of my knowledge and belief. Kansas Water Well Contractor's License No. 672 This Water Well Record was completed on (mo/day/year) 10-4-05 under the business name of Crow's Well Well by (signature) John White