

WATER WELL PLUGGING RECORD Form WWC-5P

KSA 82a-1212

ID NO.

MW-7


1 LOCATION OF WATER WELL: Fraction NW 1/4 NE 1/4 NW 1/4 NW 1/4 Section Number 4 Township Number T 25 S Range Number 16 E W
 County: Edwards

Street/Rural Address of Well Location; if unknown, distance & direction from nearest town or intersection: If at owner's address, check here South side Road M, 850 feet east of 270th Ave.

Global Positioning Systems (GPS) information:
 Latitude: 37.912125° (in decimal degrees)
 Longitude: -99.092890° (in decimal degrees)
 Elevation: 2,089.33 feet (top of casing)
 Horizontal Datum: WGS84, NAD83, NAD27
 Collection Method:

2 WATER WELL OWNER: Northern Natural Gas Co.
 RR#, St. Address, Box #: 1111 S. 103rd St.
 City, State ZIP Code: Omaha, NE 68124

GPS unit (Make/Model: Garmin / GPSmap 64csx)
 Digital Map/Photo, Topographic Map, Land Survey
 Est. Accuracy: < 3 m, 3-5 m, 5-15 m, > 15 m

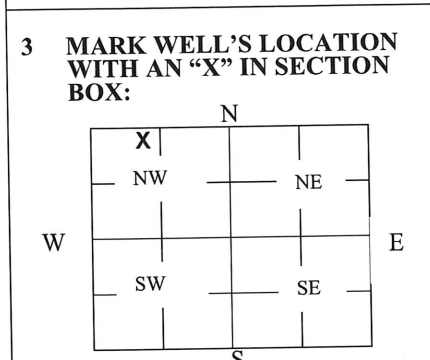

4 DEPTH OF WELL 42.40 ft. (below top of casing; casing stick-up = 2.50 ft.)
 WELL'S STATIC WATER LEVEL 36.80 ft (below top of casing)
 WELL WAS USED AS:

Domestic Public Water Supply Dewatering
 Irrigation Oil Field Water Supply Monitoring
 Feedlot Domestic (Lawn & Garden) Injection Well
 Industrial Air Conditioning Other _____

Was a chemical/bacteriological sample submitted to Department? Yes No

5 TYPE OF BLANK CASING USED:

Steel RMP (SR) Wrought Fiberglass Other (Specify below) _____
 PVC ABS Asbestos-Cement Concrete Tile

Blank casing diameter 2 in. Was casing pulled? Yes No If yes, how much 5 feet (incl. stick-up)
 Casing height above or below land surface -30 in. (after pulling top 5 feet of casing)

6 GROUT PLUG MATERIAL: Neat cement Cement grout Bentonite Other _____

Grout Plug Intervals: From 2.5 ft. to 39.9 ft., From _____ ft. to _____ ft., From _____ ft. to _____ ft.

What is the nearest source of possible contamination:

Septic tank Seepage pit Fuel storage Other (specify below) Natural gas condensate storage tank
 Sewer lines Pit privy Fertilizer storage
 Watertight sewer lines Sewage lagoon Insecticide storage
 Lateral lines Feedyard Abandoned water well Direction from well? North-northeast
 Cess pool Livestock pens Oil well/Gas well How many feet? 160

FROM	TO	PLUGGING MATERIALS	FROM	TO	PLUGGING MATERIALS
0	2.5	Soil			
2.5	33.6	Bentonite chips			
33.6	30.9	Coated bentonite pellets			

7 CONTRACTOR'S OR LANDOWNER'S CERTIFICATION: This water well was plugged under my jurisdiction and was completed on (mo/day/year) 7/11/2023 and this record is true to the best of my knowledge and belief. Kansas Water Well Contractor's License No. 416. This Water Well Record was completed on (mo/day/year) 8/10/2023 under the business name of Terracon Consultants, Inc. by (signature) Michael W. Montgomery

Send one white copy to Kansas Department of Health & Environment, Geology Section, 1000 SW Jackson Street, Ste. 420, Topeka, KS 66612-1367. Send one copy to WATER WELL OWNER and retain one for your records.
 Visit us at <http://www.kdheks.gov/waterwell/index.html> Telephone 785-296-5524.