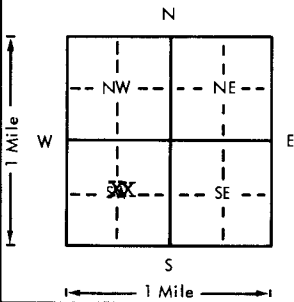


USE TYPEWRITER OR BALL POINT PEN-PRESS FIRMLY, PRINT CLEARLY.

WATER WELL RECORD
KSA 82a-1201-1215

Kansas Department of Health and Environment-Division of Environment (Water well Contractors) Topeka, Kansas 66620

1. Location of well:		County Edwards	Fraction 1/4 1/4CSW 1/4	Section number 35	Township number T 25 S R	Range number 17W E/W
2. Distance and direction from nearest town or city: Street address of well location if in city: In 2 1/4 Fellsburg, Ks.			3. Owner of well: Gabbert-Jones Inc. R.R. or street: 830 Sutton Pl. City, state, zip code: Wichita, Ks. 67202			
4. Locate with "X" in section below: Sketch map: 			6. Bore hole dia. <u>8</u> in. Completion date <u>3-22-78</u> Well depth <u>76</u> ft.			7. <input type="checkbox"/> Cable tool <input checked="" type="checkbox"/> Rotary <input type="checkbox"/> Driven <input type="checkbox"/> Dug <input type="checkbox"/> Hollow rod <input type="checkbox"/> Jetted <input type="checkbox"/> Bored <input type="checkbox"/> Reverse rotary
5. Type and color of material			From	To	8. Use: <input type="checkbox"/> Domestic <input type="checkbox"/> Public supply <input type="checkbox"/> Industry <input type="checkbox"/> Irrigation <input type="checkbox"/> Air conditioning <input type="checkbox"/> Stock <input type="checkbox"/> Lawn <input checked="" type="checkbox"/> Oil field water <input type="checkbox"/> Other	
					9. Casing: Material <input type="checkbox"/> Height: Above XXXX Threaded <input type="checkbox"/> Welded <input type="checkbox"/> Surface <u>12</u> in. RMP <input type="checkbox"/> PVC <input checked="" type="checkbox"/> Weight <u>2.8</u> lbs./ft. Dia. <u>5</u> in. to <u>76</u> ft. depth; Wall Thickness: inches or Dia. <input type="checkbox"/> in. to <input type="checkbox"/> ft. depth; gage No. <u>sch 40</u>	
					10. Screen: Manufacturer's name <u>Jetstream</u> Type <u>pvc</u> Dia. <u>5"</u> Slot/gauze <u>1/32"</u> Length <u>20'</u> Set between <u>56</u> ft. and <u>76</u> ft. <input type="checkbox"/> ft. and <input type="checkbox"/> ft. Gravel pack? <input checked="" type="checkbox"/> Size range of material <u>1/8-3/4"</u>	
					11. Static water level: <u>17</u> ft. below land surface Date <u>3-22-78</u> mo./day/yr.	
					12. Pumping level below land surfaces: <input type="checkbox"/> ft. after <input type="checkbox"/> hrs. pumping <input type="checkbox"/> g.p.m. <input type="checkbox"/> ft. after <input type="checkbox"/> hrs. pumping <input type="checkbox"/> g.p.m. Estimated maximum yield <u>100</u> g.p.m.	
					13. Water sample submitted: <input type="checkbox"/> Yes <input checked="" type="checkbox"/> No Date <input type="checkbox"/> mo./day/yr.	
					14. Well head completion: <input type="checkbox"/> Pitless adapter <u>12</u> Inches above grade	
					15. Well grouted? <input checked="" type="checkbox"/> With: <input type="checkbox"/> Neat cement <input checked="" type="checkbox"/> Bentonite <input type="checkbox"/> Concrete Depth: From <u>0</u> ft. to <u>10</u> ft.	
					16. Nearest source of possible contamination <u>oil test</u> ft. <u>55</u> Direction <u>sw</u> Type <u>oil test</u> Well disinfected upon completion? <input type="checkbox"/> Yes <input checked="" type="checkbox"/> No	
					17. Pump: <input checked="" type="checkbox"/> Not installed Manufacturer's name <input type="checkbox"/> Model number <input type="checkbox"/> HP <input type="checkbox"/> Volts <input type="checkbox"/> Length of drop pipe <input type="checkbox"/> ft. capacity <input type="checkbox"/> g.p.m. Type: <input type="checkbox"/> Submersible <input type="checkbox"/> Turbine <input type="checkbox"/> Jet <input type="checkbox"/> Reciprocating <input type="checkbox"/> Centrifugal <input type="checkbox"/> Other	
			(Use a second sheet if needed)			
18. Elevation:		19. Remarks:		20. Water well contractor's certification: This well was drilled under my jurisdiction and this report is true to the best of my knowledge and belief. Kellys Waterwell Ser 186 Business name License No. Address R2 Great Bend, Ks. Signed Kelly Price Date 9-13-78 Authorized representative		
Topography: <input type="checkbox"/> Hill <input type="checkbox"/> Slope <input checked="" type="checkbox"/> Upland <input type="checkbox"/> Valley						

T
R
E
S
E
C
1/4
1/4
1/4

Forward the white, blue and pink copies to the Department of Health and Environment

Form WWC-5