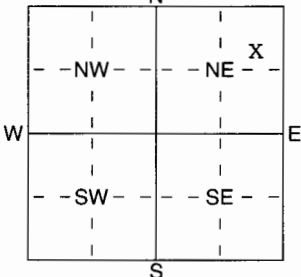


1 LOCATION OF WATER WELL: County: Edwards	Fraction C N NE 1/4 NE 1/4	Section Number 27	Township Number T 25 S	Range Number R 17 E/W
---	---	-----------------------------	----------------------------------	--

Distance and direction from nearest town or city street address of well if located within city?

2 1/2 North, 1/8 East of Fellsburg

2 WATER WELL OWNER: K & N Petroleum, Inc. RR#, St. Address, Box # : 513 E. 6th City, State, ZIP Code : Ellinwood, Ks. 67526	EDWW2941 Board of Agriculture, Division of Water Resources Application Number: 20040223
--	---

3 LOCATE WELL'S LOCATION WITH AN "X" IN SECTION BOX: 	4 DEPTH OF COMPLETED WELL 83 ft. ELEVATION:
Depth(s) Groundwater Encountered 1 ft. 2 ft. 3 ft. WELL'S STATIC WATER LEVEL 22 ft. below land surface measured on mo/day/yr 10-1-04 Pump test data: Well water was ft. after hours pumping gpm Est. Yield N/A gpm: Well water was ft. after hours pumping gpm WELL WATER TO BE USED AS: 5 Public water supply 8 Air conditioning 11 Injection well 1 Domestic 3 Feedlot 6 <u>Oil field water supply</u> 9 Dewatering 12 Other (Specify below) 2 Irrigation 4 Industrial 7 Domestic (lawn & garden) 10 Monitoring well	
Was a chemical/bacteriological sample submitted to Department? Yes No X; If yes, mo/day/yr sample was submitted Water Well Disinfected? Yes HTH No	

5 TYPE OF BLANK CASING USED: 1 Steel 3 RMP (SR) 2 PVC 4 ABS	5 Wrought iron 8 Concrete tile 6 Asbestos-Cement 9 Other (specify below)	CASING JOINTS: Glued X Clamped Welded Threaded
Blank casing diameter 5 in. to 6.3 ft., Dia in. to ft., Dia in. to ft. Casing height above land surface 36 in., weight SDR-26 lbs./ft. Wall thickness or guage No.		
TYPE OF SCREEN OR PERFORATION MATERIAL: 1 Steel 3 Stainless Steel 5 Fiberglass 7 PVC 10 Asbestos-Cement 2 Brass 4 Galvanized Steel 6 Concrete tile 8 RMP (SR) 11 Other (Specify) 9 ABS 12 None used (open hole)		
SCREEN OR PERFORATION OPENINGS ARE: 1 Continuous slot 3 Mill slot 5 Gauzed wrapped 8 <u>Saw cut</u> 11 None (open hole) 2 Louvered shutter 4 Key punched 6 Wire wrapped 9 Drilled holes 7 Torch cut 10 Other (specify)		
SCREEN-PERFORATED INTERVALS: From 83 ft. to 63 ft., From ft. to ft. From ft. to ft., From ft. to ft. GRAVEL PACK INTERVALS: From 83 ft. to 20 ft., From ft. to ft. From ft. to ft., From ft. to ft.		

6 GROUT MATERIAL: 1 Neat cement 2 Cement grout 3 Bentonite 4 Other hole plug
Grout Intervals: From 20 ft. to 0 ft., From ft. to ft., From ft. to ft.
What is the nearest source of possible contamination: 1 Septic tank 4 Lateral lines 7 Pit privy 10 Livestock pens 14 Abandoned water well 2 Sewer lines 5 Cess pool 8 Sewage lagoon 11 Fuel storage 15 Oil well/Gas well 3 Watertight sewer lines 6 Seepage pit 9 Feedyard 12 Fertilizer storage 16 Other (specify below) 9 Feedyard 13 Insecticide storage None
Direction from well? How many feet?

FROM	TO	LITHOLOGIC LOG	FROM	TO	PLUGGING INTERVALS
0	5	Sandy clay			
5	20	Sand & gravel			
20	24	Clay			
24	83	Sand & gravel			

RECEIVED
NOV 29 2004
BUREAU OF WATER

7 CONTRACTOR'S OR LANDOWNER'S CERTIFICATION: This water well was (1) <u>constructed</u> , (2) reconstructed, or (3) plugged under my jurisdiction and was completed on (mo/day/year) 10-1-04 and this record is true to the best of my knowledge and belief. Kansas Water Well Contractor's Licence No 134 This Water Well Record was completed on (mo/day/yr) 10-6-04 under the business name of Rosencrantz- Bemis by (signature) <i>Xana Alebe</i>
