

**WATER WELL PLUGGING RECORD Form WWC-5P**
**KSA 82a-1212**
**ID NO.**
**17727**

<b>1 LOCATION OF WATER WELL:</b> County: <b>Edwards</b>	Fraction $\frac{1}{4}$ N $\frac{1}{4}$ C $\frac{1}{4}$ SE $\frac{1}{4}$	Section Number <b>7</b>	Township Number <b>T 25 S</b>	Range Number <b>17</b> <input type="checkbox"/> E <input checked="" type="checkbox"/> W
--	--	----------------------------	----------------------------------	--

Street/Rural Address of Well Location; if unknown, distance & direction from nearest town or intersection: If at owner's address, check here ☐ 3 1/8 south 1 1/8 east of Lewis

**Global Positioning Systems (GPS) information:**

Latitude: \_\_\_\_\_ (in decimal degrees)

Longitude: \_\_\_\_\_ (in decimal degrees)

Elevation: \_\_\_\_\_

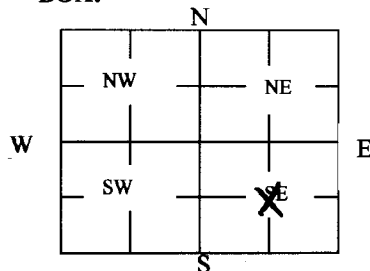
Datum: ☐ WGS84, ☐ NAD83, ☐ NAD27

**Collection Method:**
☐ GPS unit (Make/Model: \_\_\_\_\_)

☐ Digital Map/Photo, ☐ Topographic Map, ☐ Land Survey

Est. Accuracy: ☐ < 3 m, ☐ 3-5 m, ☐ 5-15 m, ☐ > 15 m

**2 WATER WELL OWNER:** **Edwards Land Investment**  
RR#, St. Address, Box #: **553 R Road**  
City, State ZIP Code: **Pawnee Rock, 67567**

**3 MARK WELL'S LOCATION WITH AN "X" IN SECTION BOX:**

**4 DEPTH OF WELL** 86 **ft.**

WELL'S STATIC WATER LEVEL 50 **ft**
**WELL WAS USED AS:**
☐ Domestic  
☒ Irrigation  
☐ Feedlot  
☐ Industrial

☐ Public Water Supply  
☐ Oil Field Water Supply  
☐ Domestic (Lawn & Garden)  
☐ Air Conditioning

☐ Dewatering  
☐ Monitoring  
☐ Injection Well  
☐ Other \_\_\_\_\_

Was a chemical/bacteriological sample submitted to Department? Yes ☐ No ☒
**5 TYPE OF BLANK CASING USED:**
☐ Steel  
☐ PVC

☐ RMP (SR)  
☐ ABS

☐ Wrought  
☐ Asbestos-Cement

☐ Fiberglass  
☐ Concrete Tile

☒ Other (Specify below)  
Transite

Blank casing diameter 16 in. Was casing pulled? Yes ☐ No ☒ If yes, how much \_\_\_\_\_  
Casing height above or below land surface 12 in.

**6 GROUT PLUG MATERIAL:** ☐ Neat cement ☒ Cement grout ☒ Bentonite ☐ Other \_\_\_\_\_

Grout Plug Intervals: From 21 ft. to 0 ft., From 50 ft. to 21 ft., From \_\_\_\_\_ to \_\_\_\_\_ ft.

**What is the nearest source of possible contamination:**
☐ Septic tank  
☐ Sewer lines  
☐ Watertight sewer lines  
☐ Lateral lines  
☐ Cess pool

☐ Seepage pit  
☐ Pit privy  
☐ Sewage lagoon  
☐ Feedyard  
☐ Livestock pens

☐ Fuel Storage  
☐ Fertilizer storage  
☐ Insecticide storage  
☐ Abandoned water well  
☐ Oil well/Gas well

☐ Other (specify below)  
None

Direction from well? \_\_\_\_\_  
How many feet? \_\_\_\_\_

FROM	TO	PLUGGING MATERIALS	FROM	TO	PLUGGING MATERIALS
86	50	Chlorinated gravel			
50	21	Bentonite			
21	0	Concrete			

**7 CONTRACTOR'S OR LANDOWNER'S CERTIFICATION:** This water well was plugged under my jurisdiction and was completed on (mo/day/year) 3-23-12 and this record is true to the best of my knowledge and belief. Kansas Water Well Contractor's License No. 134. This Water Well Record was completed on (mo/day/year) 4-18-12 under the business name of Rosencrantz-Bemis by (signature) [Signature]

**INSTRUCTIONS:** Use typewriter or ballpoint pen. Please press firmly and print clearly. Please fill in blanks, underline or circle the correct answers. Send top three copies to Kansas Department of Health and Environment, Bureau of Water, Geology Section, 1000 SW Jackson St., Ste. 420, Topeka, Kansas 66612-1367. Telephone: 785/296-5524. Send one to Water Well Owner and retain one for your records. Visit us at <http://www.kdheks.gov/waterwell/index.html>.

Check one: ☒ White Copy ☐ Blue Copy ☐ Pink Copy