


1 LOCATION OF WATER WELL: Fraction NW 1/4 NW 1/4 Section Number 18 Township Number T 26 S Range Number R 17 EW
 County: Edwards Distance and direction from nearest town or city street address of well if located within city? 30
~~65-1-E Lewis Kansas~~ 65-1-E Lewis Kansas

2 WATER WELL OWNER: Marlin Butler Board of Agriculture, Division of Water Resources
 RR#, St. Address, Box #: Lewis Kansas Application Number:
 City, State, ZIP Code:

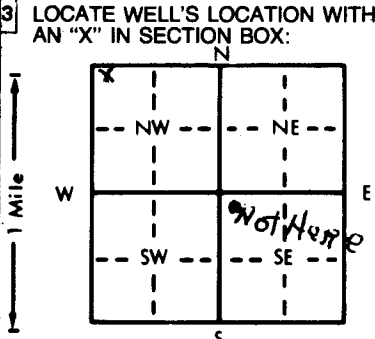

4 DEPTH OF COMPLETED WELL: 60 ft. ELEVATION:
 Depth(s) Groundwater Encountered 1 33 ft. 2 33 ft. 3 33 ft.
 WELL'S STATIC WATER LEVEL 33 ft. below land surface measured on mo/day/yr 3-30-83
 Pump test data: Well water was 33 ft. after 1 hours pumping 3 gpm
 Est. Yield 10 gpm; Well water was 33 ft. after 3 hours pumping 3 gpm
 Bore Hole Diameter 8 3/4 in. to 8 3/4 in. and 8 3/4 in. to 8 3/4 in.
 WELL WATER TO BE USED AS:
 5 Public water supply 8 Air conditioning 11 Injection well
 1 Domestic 3 Feedlot 6 Oil field water supply 9 Dewatering 12 Other (Specify below)
 2 Irrigation 4 Industrial 7 Lawn and garden only 10 Observation well
 Was a chemical/bacteriological sample submitted to Department? Yes X No X; If yes, mo/day/yr sample was submitted
 Water Well Disinfected? Yes X No X

5 TYPE OF BLANK CASING USED:
 1 Steel 3 RMP (SR) 6 Asbestos-Cement 9 Other (specify below) SDR-26
 2 PVC 4 ABS 7 Fiberglass 10 Asbestos-cement
 Casing height above land surface 12 in., weight 40 lbs./ft. Wall thickness or gauge No. SDR-26
 TYPE OF SCREEN OR PERFORATION MATERIAL:
 1 Steel 3 Stainless steel 5 Fiberglass 7 PVC 10 Asbestos-cement
 2 Brass 4 Galvanized steel 6 Concrete tile 8 RMP (SR) 11 Other (specify) SDR-26
 9 ABS 12 None used (open hole)
 SCREEN OR PERFORATION OPENINGS ARE:
 1 Continuous slot 3 Mill slot 5 Gauzed wrapped 8 Saw cut 11 None (open hole)
 2 Louvered shutter 4 Key punched 6 Wire wrapped 9 Drilled holes
 7 Torch cut 10 Other (specify)
 SCREEN-PERFORATED INTERVALS: From 40 ft. to 60 ft. From 40 ft. to 60 ft.

6 GROUT MATERIAL: 1 Neat cement 2 Cement grout 3 Bentonite 4 Other
 What is the nearest source of possible contamination:
 1 Septic tank 4 Lateral lines 7 Pit privy 10 Livestock pens 14 Abandoned water well
 2 Sewer lines 5 Cess pool 8 Sewage lagoon 11 Fuel storage 15 Oil well/Gas well
 3 Watertight sewer lines 6 Seepage pit 9 Feedyard 12 Fertilizer storage 16 Other (specify below) PASTURE
 13 Insecticide storage

Direction from well? _____ How many feet? _____

FROM	TO	LITHOLOGIC LOG	FROM	TO	LITHOLOGIC LOG
0	1	TOP SOIL			
1	3	Silt Sand			
3	11	tan Clay			
11	16	SAND & GRAVEL			
16	21	GRAY CLAY			
21	30	GRAVEL			
30	33	CLAY			
33	60	GRAVEL			

7 CONTRACTOR'S OR LANDOWNER'S CERTIFICATION: This water well was (1) constructed, (2) reconstructed, or (3) plugged under my jurisdiction and was completed on (mo/day/year) 3-30-83 and this record is true to the best of my knowledge and belief. Kansas Water Well Contractor's License No. 224 This Water Well Record was completed on (mo/day/yr) 7-23-83 under the business name of Carl Hayes Water Well Sew. by (signature) Carl Hayes

INSTRUCTIONS: Use typewriter or ball point pen, PLEASE PRESS FIRMLY and PRINT clearly. Please fill in blanks, underline or circle the correct answers. Send top three copies to Kansas Department of Health and Environment, Division of Environment, Environmental Geology Section, Topeka, KS 66620. Send one to WATER WELL OWNER and retain one for your records.

OFFICE USE ONLY
T 25 R 17 EW SEC 30