WATER WELL PLUGGING RECORD Form WWC-5P KSA 82a-1212 ID NO.

1 LOCATION OF WATER WELL: County: Edwards	Fraction ¼ SE ¼ SW ¼ SE ¼	Section Number 14	Township Number T 25 S	Range Number 17 ☐ E ☑ W

Street/Rural Address of Well Location; if unknown, distance & direction from nearest town or intersection: If at owner's address, check here ☐ 4 North, 1 East of Fellsburg

Global Positioning Systems (GPS) information:
Latitude: _____ (in decimal degrees)
Longitude: _____ (in decimal degrees)
Elevation: _____
Horizontal Datum: ☐ WGS84, ☐ NAD83, ☐ NAD27
Collection Method:
☐ GPS unit (Make/Model: _____
☐ Digital Map/Photo, ☐ Topographic Map, ☐ Land Survey
Est. Accuracy: ☐ < 3 m, ☐ 3-5 m, ☐ 5-15 m, ☐ > 15 m

2 WATER WELL OWNER: Leland Higbie
RR#, St. Address, Box #: 2650 P Road
City, State ZIP Code: Lewis, KS 67552

3 MARK WELL'S LOCATION WITH AN "X" IN SECTION BOX:

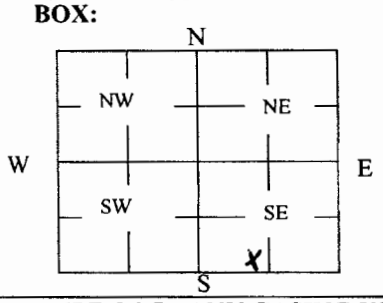

4 DEPTH OF WELL 25 ft.

WELL'S STATIC WATER LEVEL N/A ft

WELL WAS USED AS:

☑ Domestic ☐ Irrigation ☐ Feedlot ☐ Industrial
☐ Public Water Supply ☐ Oil Field Water Supply ☐ Domestic (Lawn & Garden) ☐ Air Conditioning
☐ Dewatering ☐ Monitoring ☐ Injection Well ☐ Other _____

Was a chemical/bacteriological sample submitted to Department? Yes ☐ No ☑

5 TYPE OF BLANK CASING USED:

☑ Steel ☐ PVC ☐ RMP (SR) ☐ ABS ☐ Wrought ☐ Asbestos-Cement ☐ Fiberglass ☐ Concrete Tile ☐ Other (Specify below) _____

Blank casing diameter 5 in. Was casing pulled? Yes ☐ No ☑ If yes, how much _____
Casing height above or below land surface 60 in.

6 GROUT PLUG MATERIAL: ☐ Neat cement ☐ Cement grout ☑ Bentonite ☐ Other _____

Grout Plug Intervals: From _____ ft. to _____ ft., From 25 ft. to 5 ft., From _____ ft. to _____ ft.

What is the nearest source of possible contamination:
☐ Septic tank ☐ Sewer lines ☐ Watertight sewer lines ☐ Lateral lines ☐ Cess pool
☐ Seepage pit ☐ Pit privy ☐ Sewage lagoon ☐ Feedyard ☐ Livestock pens
☐ Fuel storage ☐ Fertilizer storage ☐ Insecticide storage ☐ Abandoned water well ☐ Oil well/Gas well
☑ Other (specify below) House
Direction from well? Northeast
How many feet? 25ft

FROM	TO	PLUGGING MATERIALS	FROM	TO	PLUGGING MATERIALS
25	5	Hole plug			

7 CONTRACTOR'S OR LANDOWNER'S CERTIFICATION: This water well was plugged under my jurisdiction and was completed on (mo/day/year) 7-1-19 and this record is true to the best of my knowledge and belief. Kansas Water Well Contractor's License No. 134. This Water Well Record was completed on (mo/day/year) 7-11-19 under the business name of Rosencrantz- Bemis Ent Inc by (signature) [signature]

Send one white copy to Kansas Department of Health & Environment, Geology Section, 1000 SW Jackson Street, Ste. 420, Topeka, KS 66612-1367. Send one copy to WATER WELL OWNER and retain one for your records.
Visit us at http://www.kdheks.gov/waterwell/index.html Telephone 785-296-5524.