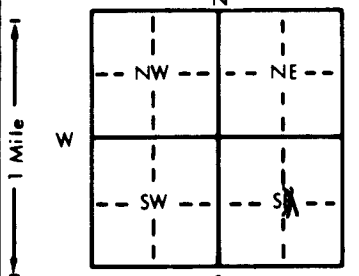


1 LOCATION OF WATER WELL:	Fraction	Section Number	Township Number	Range Number
County: Edwards	N ¼ C ¼ SE ¼	31	T 25 S	R 18 E/W

Distance and direction from nearest town or city street address of well if located within city?

3½ west of Centerview, Ks. 1¼ north

2 WATER WELL OWNER:	Turner Farms
RR#, St. Address, Box # :	Rt., 1-Box 129J
City, State, ZIP Code :	Great Bend, Ks. 67530
	Board of Agriculture, Division of Water Resources
	Application Number: 35,362

3 LOCATE WELL'S LOCATION WITH AN "X" IN SECTION BOX:	4 DEPTH OF COMPLETED WELL . . . 150 . . . ft. ELEVATION:
	Depth(s) Groundwater Encountered 1. ft. 2. ft. 3. ft.
	WELL'S STATIC WATER LEVEL . . . 40 . . . ft. below land surface measured on mo/day/yr . . 3-13-95
	Pump test data: Well water was ft. after hours pumping gpm
	Est. Yield . . 600 . . gpm: Well water was . . 100 . . ft. after . . 4 . . . hours pumping . . 600 . . gpm
	Bore Hole Diameter . . . 26 . . in. to . . 150 . . ft., and in. to ft.
	WELL WATER TO BE USED AS: 5 Public water supply 8 Air conditioning 11 Injection well
	1 Domestic 3 Feedlot 6 Oil field water supply 9 Dewatering 12 Other (Specify below)
	2 Irrigation 4 Industrial 7 Lawn and garden only 10 Monitoring well
	Was a chemical/bacteriological sample submitted to Department? Yes No X If yes, mo/day/yr sample was submitted
	Water Well Disinfected? Yes No

5 TYPE OF BLANK CASING USED:	5 Wrought iron	8 Concrete tile	CASING JOINTS: Glued . X . . . Clamped
1 Steel	3 RMP (SR)	6 Asbestos-Cement	9 Other (specify below)
2 PVC	4 ABS	7 Fiberglass	10 Asbestos-cement
Blank casing diameter 16 . . in. to . . 70 . . ft., Dia . . 16 . . in. to 90 to 130 ft., Dia in. to ft.			
Casing height above land surface 12 . . in., weight . . SDR 32.5 . . lbs./ft. Wall thickness or gauge No.			
TYPE OF SCREEN OR PERFORATION MATERIAL:	5 Fiberglass	8 RMP (SR)	11 Other (specify)
1 Steel	3 Stainless steel	6 Concrete tile	9 ABS
2 Brass	4 Galvanized steel	7 Torch cut	10 Other (specify)
SCREEN OR PERFORATION OPENINGS ARE:	5 Gauzed wrapped	8 Saw cut	11 None (open hole)
1 Continuous slot	3 Mill slot	6 Wire wrapped	9 Drilled holes
2 Louvered shutter	4 Key punched	7 Torch cut	10 Other (specify)
SCREEN-PERFORATED INTERVALS: From . . 70 . . ft. to . . 90 . . ft., From . . 130 . . ft. to . . 150 . . ft.			
GRAVEL PACK INTERVALS: From . . 20 . . ft. to . . 60 . . ft., From . . 64 . . ft. to . . 92 . . ft.			
From . . 95 . . ft. to . . 150 . . ft., From ft. to ft.			

6 GROUT MATERIAL: 1 Neat cement	2 Cement grout	3 Bentonite	4 Other hole plug
Grout Intervals: From . . 0 . . ft. to . . 20 . . ft., From . . 60 . . ft. to . . 64 . . ft., From . . 92 . . ft. to . . 95 . . ft.			
What is the nearest source of possible contamination:	7 Pit privy	10 Livestock pens	14 Abandoned water well
1 Septic tank	4 Lateral lines	11 Fuel storage	15 Oil well/Gas well
2 Sewer lines	5 Cess pool	12 Fertilizer storage	16 Other (specify below)
3 Watertight sewer lines	6 Seepage pit	13 Insecticide storage	
Direction from well?	9 Feedyard	How many feet?	none

FROM	TO	LITHOLOGIC LOG	FROM	TO	PLUGGING INTERVALS
0	3	Top soil			
3	19	Brown & gray clay			
19	26	Fine sand and gravel			
26	40½	Sand and gravel			
40½	46	Brown & white clay			
46	50	Fine sand			
50	60	Sand and gravel clean, coarse, loose			
60	73	Brown & white clay			
73	91	Sand and gravel clean, coarse, loose			
91	131	brown & white clay			
131	146	Sand and gravel clean, coarse, loose			
146	150	Light gray clay			

7 CONTRACTOR'S OR LANDOWNER'S CERTIFICATION: This water well was (1) constructed, (2) reconstructed, or (3) plugged under my jurisdiction and was completed on (mo/day/year) . . . 9-16-95 and this record is true to the best of my knowledge and belief. Kansas Water Well Contractor's License No. 134 This Water Well Record was completed on (mo/day/yr) . . 9-18-95 under the business name of Rosencrantz-Bemis by (signature) Fredia Rodan
--