


1 LOCATION OF WATER WELL: County: Edwards Fraction: NW 1/4 SW 1/4 SW 1/4 Section Number: 4 Township Number: T 25 S Range Number: R 18 E/W

Distance and direction from nearest town or city street address of well if located within city? 5 1/4 east 3/4 South of Kinsley, Ks.

2 WATER WELL OWNER: RR#, St. Address, Box #: Allen Drilling Box 1389 City, State, ZIP Code: Great Bend, Ks. 67530 Board of Agriculture, Division of Water Resources Application Number: 900465

3 LOCATE WELL'S LOCATION WITH AN "X" IN SECTION BOX:

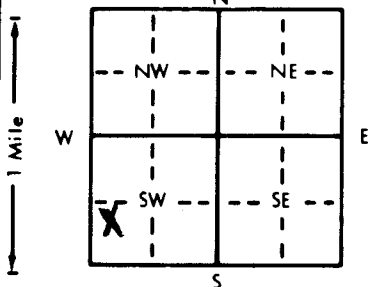

4 DEPTH OF COMPLETED WELL: 80 ft. ELEVATION: ... WELL'S STATIC WATER LEVEL: 30 ft. below land surface measured on mo/day/yr 10-26-90 Pump test data: Well water was ... Est. Yield: na gpm ... Bore Hole Diameter: 10 in. to 80 in. ... WELL WATER TO BE USED AS: 5 Public water supply, 8 Air conditioning, 11 Injection well, 1 Domestic, 3 Feedlot, 6 Oil field water supply, 9 Dewatering, 12 Other (Specify below), 2 Irrigation, 4 Industrial, 7 Lawn and garden only, 10 Monitoring well ... Was a chemical/bacteriological sample submitted to Department? Yes... No... X...; If yes, mo/day/yr sample was submitted ... Water Well Disinfected? Yes hth No

5 TYPE OF BLANK CASING USED: 1 Steel, 2 PVC, 3 RMP (SR), 4 ABS, 5 Wrought iron, 6 Asbestos-Cement, 7 Fiberglass, 8 Concrete tile, 9 Other (specify below), CASING JOINTS: Glued X Clamped, Welded, Threaded ... Blank casing diameter: 5 in. to 60 ft., Dia. ... Casing height above land surface: 18 in., weight: 258 lbs./ft. Wall thickness or gauge No. ... TYPE OF SCREEN OR PERFORATION MATERIAL: 1 Steel, 2 Brass, 3 Stainless steel, 4 Galvanized steel, 5 Fiberglass, 6 Concrete tile, 7 PVC, 8 RMP (SR), 9 ABS, 10 Asbestos-cement, 11 Other (specify), 12 None used (open hole) ... SCREEN OR PERFORATION OPENINGS ARE: 1 Continuous slot, 2 Louvered shutter, 3 Mill slot, 4 Key punched, 5 Gauzed wrapped, 6 Wire wrapped, 7 Torch cut, 8 Saw cut, 9 Drilled holes, 11 None (open hole), 10 Other (specify) ... SCREEN-PERFORATED INTERVALS: From 60 ft. to 80 ft., From ... GRAVEL PACK INTERVALS: From 20 ft. to 47 ft., From 50 ft. to 80 ft., From ...

6 GROUT MATERIAL: 1 Neat cement, 2 Cement grout, 3 Bentonite, 4 Other hole plug 47' to 50' ... Grout Intervals: From 0 ft. to 20 ft., From ... What is the nearest source of possible contamination: 1 Septic tank, 2 Sewer lines, 3 Watertight sewer lines, 4 Lateral lines, 5 Cess pool, 6 Seepage pit, 7 Pit privy, 8 Sewage lagoon, 9 Feedyard, 10 Livestock pens, 11 Fuel storage, 12 Fertilizer storage, 13 Insecticide storage, 14 Abandoned water well, 15 Oil well/Gas well, 16 Other (specify below) ... Direction from well? north How many feet? 100

FROM	TO	LITHOLOGIC LOG	FROM	TO	PLUGGING INTERVALS
0	3	Sandy top soil			
3	9	Gray clay			
9	14	Brown clay			
14	27	Fine sand and gravel			
47	49	Brown clay			
49	79	Sand and gravel clean coarse loose			
79	80	Brown & white clay			

7 CONTRACTOR'S OR LANDOWNER'S CERTIFICATION: This water well was (1) constructed, (2) reconstructed, or (3) plugged under my jurisdiction and was completed on (mo/day/year) 10-26-90 and this record is true to the best of my knowledge and belief. Kansas Water Well Contractor's License No. 134 This Water Well Record was completed on (mo/day/yr) 11-6-90 under the business name of Rosencrantz-Bemis by (signature) India Hodson

OFFICE USE ONLY T R E/W SEC.