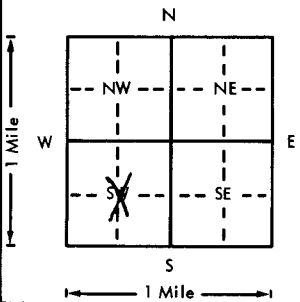


USE TYPEWRITER OR BALL POINT PEN-PRESS FIRMLY, PRINT CLEARLY.

WATER WELL RECORD  
KSA 82a-1201-1215

Kansas Department of Health and Environment-Division of Environment  
(Water well Contractors)  
Topeka, Kansas 66620

1. Location of well: County <u>Edwards</u>		Fraction <u>1/3W</u> 1/4 1/4 1/4		Section number <u>6</u>	Township number <u>25 S</u>	Range number <u>18 E/W</u>
2. Distance and direction from nearest town or city: <u>2.5 - 4 3/4 W of Lewis</u>				3. Owner of well: <u>Dwight Slentz</u> R.R. or street: City, state, zip code: <u>Lewis, Ks.</u>		
4. Locate with "X" in section below: Sketch map: 				6. Bore hole dia. <u>29</u> in. Completion date <u>3-18-76</u> Well depth <u>100</u> ft.		
5. Type and color of material				7. <input type="checkbox"/> Cable tool <input checked="" type="checkbox"/> Rotary <input type="checkbox"/> Driven <input type="checkbox"/> Dug <input type="checkbox"/> Hollow rod <input type="checkbox"/> Jetted <input type="checkbox"/> Bored <input type="checkbox"/> Reverse rotary		
				8. Use: <input type="checkbox"/> Domestic <input type="checkbox"/> Public supply <input type="checkbox"/> Industry <input checked="" type="checkbox"/> Irrigation <input type="checkbox"/> Air conditioning <input type="checkbox"/> Stock <input type="checkbox"/> Lawn <input type="checkbox"/> Oil field water <input type="checkbox"/> Other		
				9. Casing: Material <u>Steel</u> Height: <u>Above or below</u> Threaded <input type="checkbox"/> Welded <input checked="" type="checkbox"/> Surface <u>18</u> in. RMP <input type="checkbox"/> PVC <input type="checkbox"/> Weight <input type="checkbox"/> lbs./ft. Dia. <u>16</u> in. to <u>100</u> ft. depth Wall Thickness: inches or Dia. <input type="checkbox"/> in. to <input type="checkbox"/> ft. depth gage No. <u>7</u>		
				10. Screen: Manufacturer's name <u>Deerns</u> Type <u>steel</u> Dia. <u>16</u> Gauge <u>3/16</u> Length <u>56</u> Set between <u>44</u> ft. and <u>100</u> ft. ft. and <input type="checkbox"/> ft. Gravel pack? <input checked="" type="checkbox"/> Size range of material <u>1/2 3/4 3/8</u>		
				11. Static water level: <u>23 1/2</u> ft. below land surface Date <u>2-2-76</u> mo./day/yr.		
				12. Pumping level below land surfaces: ____ ft. after ____ hrs. pumping <u>NA</u> g.p.m. ____ ft. after ____ hrs. pumping <u>NA</u> g.p.m. Estimated maximum yield _____ g.p.m.		
				13. Water sample submitted: <u>Yes</u> <input checked="" type="checkbox"/> No <input type="checkbox"/> Date <u>12-3-75</u> mo./day/yr.		
				14. Well head completion: <input type="checkbox"/> Pitless adapter _____ Inches above grade		
				15. Well grouted? <input checked="" type="checkbox"/> With: <input type="checkbox"/> Neat cement <input type="checkbox"/> Bentonite <input checked="" type="checkbox"/> Concrete Depth: From <u>0</u> ft. to <u>10</u> ft.		
				16. Nearest source of possible contamination: ft. <u>100</u> Direction <u>N</u> Type <u>Septic</u> Well disinfected upon completion? <input type="checkbox"/> Yes <input type="checkbox"/> No		
				17. Pump: <input type="checkbox"/> Not installed Manufacturer's name <u>WLR</u> Model number <u>3-BH-12</u> HP <u>80</u> Volts _____ Length of drop pipe <u>80</u> ft. capacity _____ g.p.m. Type: <input type="checkbox"/> Submersible <input checked="" type="checkbox"/> Turbine <input type="checkbox"/> Jet <input type="checkbox"/> Reciprocating <input type="checkbox"/> Centrifugal <input type="checkbox"/> Other		
18. Elevation:				19. Remarks:		
Topography: <input type="checkbox"/> Hill <input checked="" type="checkbox"/> Slope <input type="checkbox"/> Upland <input type="checkbox"/> Valley				20. Water well contractor's certification: This well was drilled under my jurisdiction and this report is true to the best of my knowledge and belief. <u>Rosenblatt - Bemis 134</u> Business name License No. Address <u>Great Bend, Ks.</u> Signed <u>Fredia Redson</u> Date <u>9/29/76</u> Authorized representative		

T 25  
 R 18 E  
 Sec 6  
 1/4 1/4 1/4 1/4 CSW

Forward the white, blue and pink copies to the Department of Health and Environment

Form WWC-5